
AUTHORITY	DATE INSTALLED OR RETIRED	DESCRIPTION
C-21350 A.F.E. 4783	Retired October 1923	As Bridge No.516 is no longer required and was in bad condition it was removed and replaced with a cinder fill. East backwall was at sta.1734+96.5

Continued on typed list.

PERRY COUNTY, O.

JACKSON & PIKE TWPS

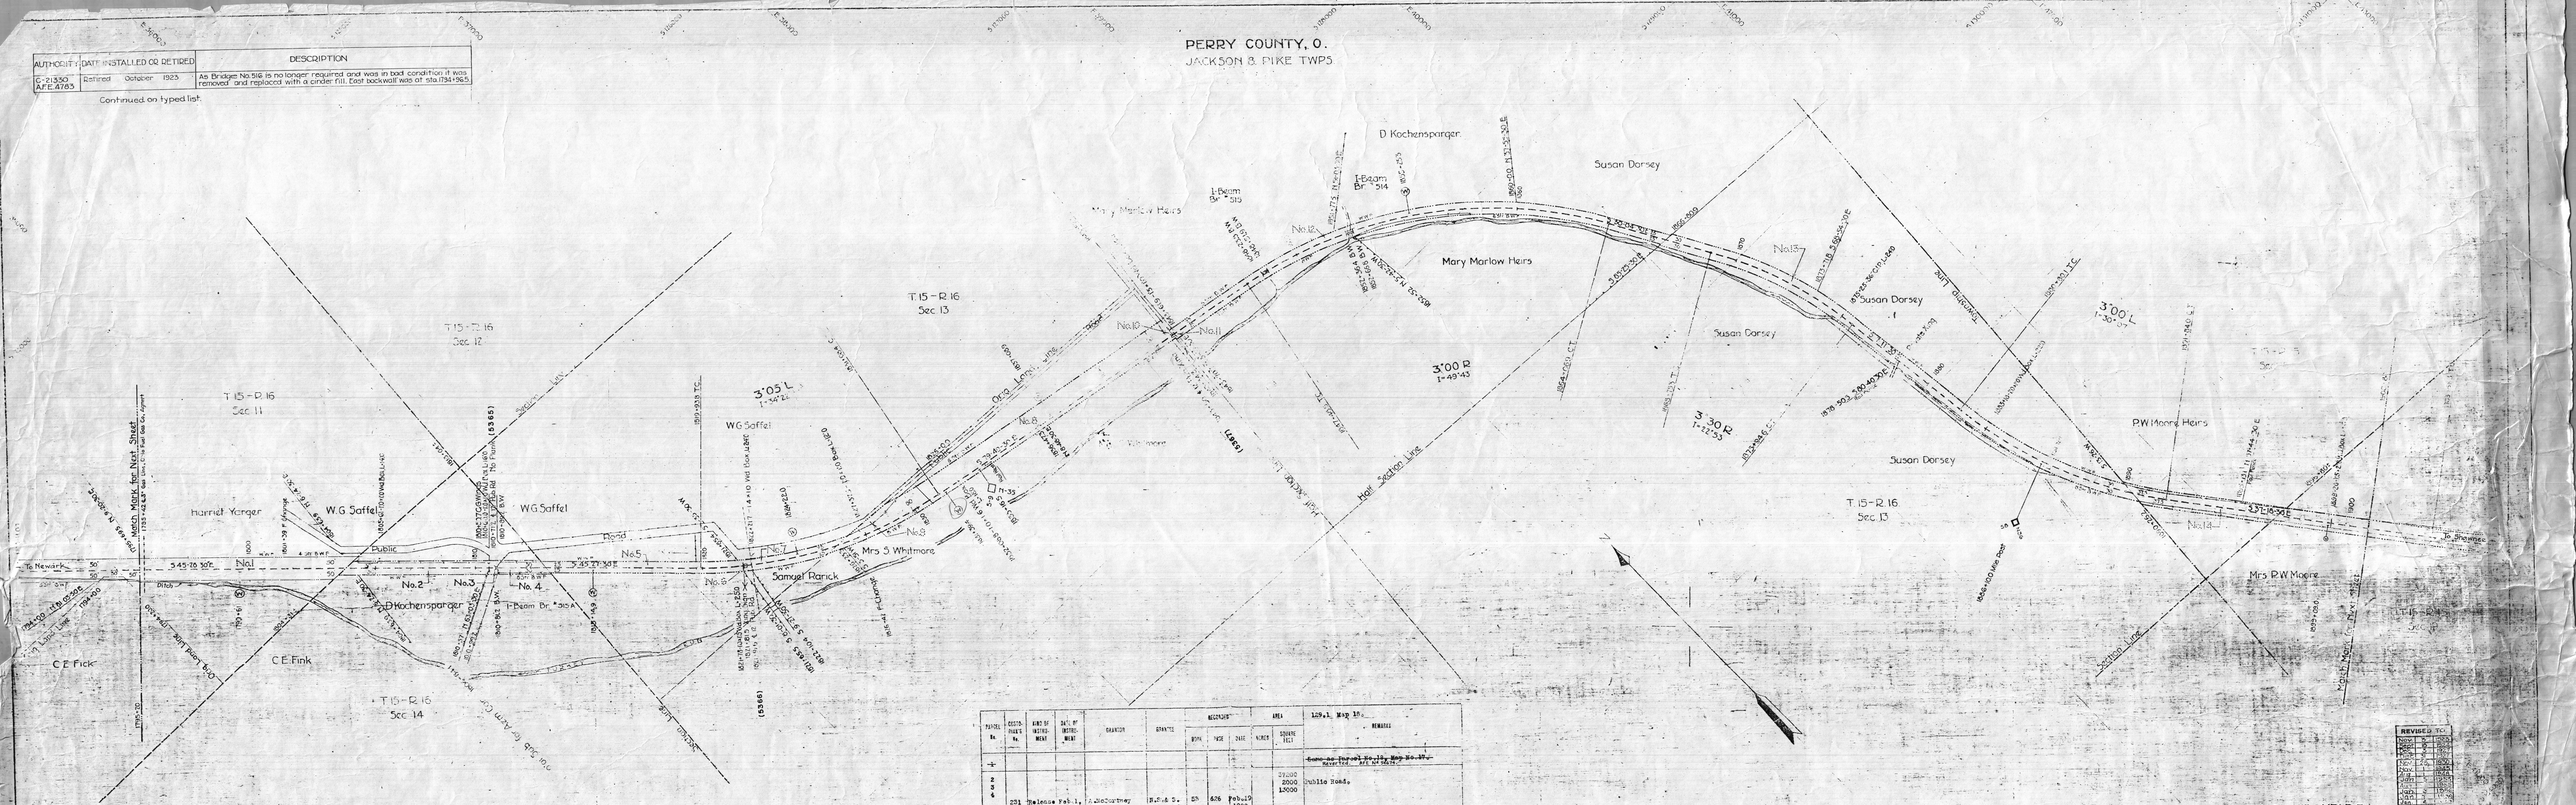

Parcel No.	Custodian's No.	Kind of Instrument	Date of Instrument	Grantor	Grantee	Recorded Book	Recorded Page	Recorded Date	Area Acres	Area Square Feet	Remarks
	304	Release	Oct.14,1925	B.&O.R.R. Co.	Rushcreek Conservancy District				14.854		Parcels 5 thru 14

Parcel No.	Custodian's No.	Kind of Instrument	Date of Instrument	Grantor	Grantee	Recorded Book	Recorded Page	Recorded Date	Area Acres	Area Square Feet	Remarks
~~1~~				~~Conv. to Parcel 5 on Sht. Map No. 37. Rewritten AFE 54CTA B-7-1~~							
2 3 4	231	Release	Feb.1, 1871	J. McCartney	B.&O.R.R. Co.	54	626	Feb.19 1900		27000 2000 12000	Public Roads.
5 6 7	232	Cond.	Mar.18, 1871	Jacob Parick	B.&O.R.R. Co.	3	60	Mar.18 1871		1200 1960	Public Roads. Data taken from B.& O.Record Vol.4,Pg. 120. Parcels 5, 6 & 7 Released See Cust #304
8 9 10	233	Cond.	Apr.24, 1871	Magdalena Burling, et al Wells for Sam'l. Barsky Bro.	B.&O.R.R. Co.	3	49	Apr.24 1871	0.618	5400 1600	Public Road. Public Road. Data taken from B. & O. Record Vol.4, Pg. 119. Parcels 8,9, & 10 Released See Cust #304
11 12	234	Cond.	June 29 1871	Frith Workman	B.&O.R.R. Co.	4 Proj.Co.	321	June29 1871	0.650	920	Public Road. Parcels 11 & 12 Released See Cust # 304
13	216	Release	Nov.30, 1870	George Wolf	B.&O.R.R. Co.				0.200		Released See Cust # 304 Conv. Also Sewer Parcel No.10, Map 14 & Part of Parcel 11 Map No.37.
14	235	Deed	June 24 1876	T.J. Davis et al	B.&O.R.R. Co.	21	169	Jan.17 1878	0.190		Released See Cust. #304 Conv. Also Sewer Parcels 14 and 9, Map No.10. Same as Parcel, Map No.19.

Sheet No. 16 of 22 primary and 3 supplemental sheets

No.	REVISIONS	REFERENCE	DATE	A.F.E.	BY
1	Release of Parcels 5 thru 14	Release of 10-14-25	7-28-54	--	RAH

REVISED TO:	
