T&O-C ~ ZW To NYC
Monroe - Corning

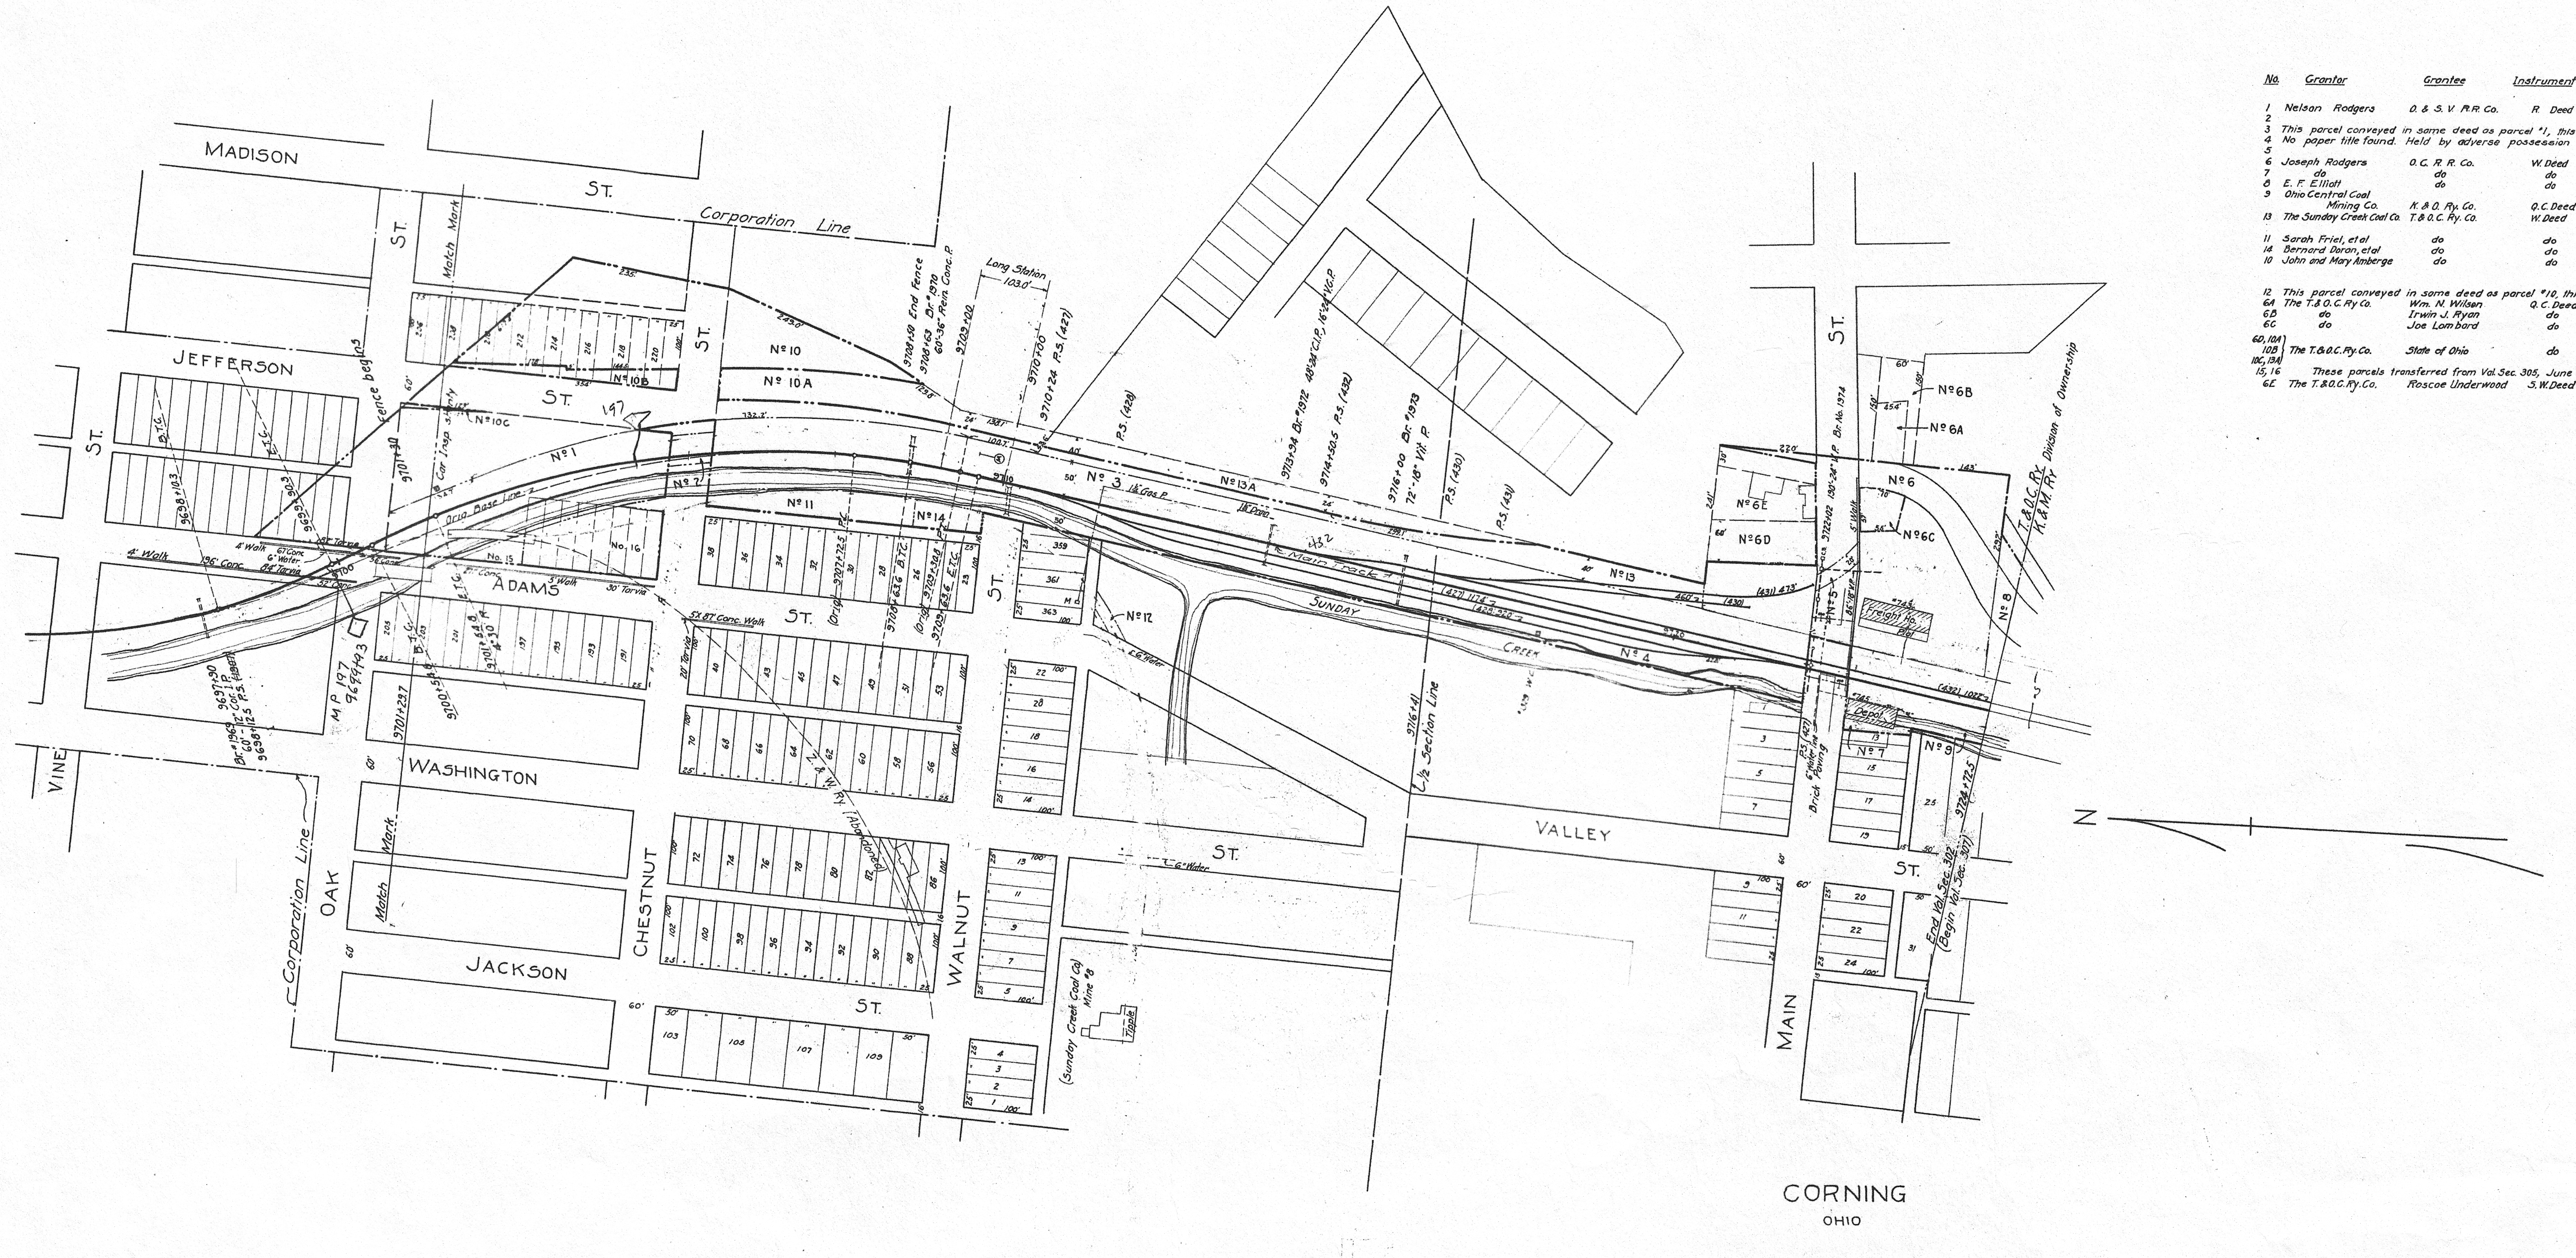

CORNING
OHIO

SCHEDULE OF PROPERTY

No.	Grantor	Grantee	Instrument	Date	Record		Cust. No.	Remarks
1	Nelson Rodgers	O. & S. V. R.R. Co.	R. Deed	Dec. 21, 1887	DB V37 P441	Apr. 24, 1889	68 ~~2705~~	This is a part of parcel #12 Map 101 Right to cross Chestnut St.
2								
3	This parcel conveyed in same deed as parcel #1, this map.							
4	No paper title found. Held by adverse possession and claimed by Ry. Co.						79 ~~2717~~	
5								Right to cross Main St.
6	Joseph Rodgers	O. C. R. R. Co.	W. Deed	Jan. 27, 1880	DB V26 P296	Oct. 3, 1881	78 ~~2718~~	
7	do	do	do	Sept. 7, 1881	DB V26 P279	Oct. 1, 1881	84 ~~2719~~	
8	E. F. Elliott	do	do	Mar. 17, 1883	DB V29 P70	Apr. 6, 1883	3 ~~2720~~	
9	Ohio Central Coal Mining Co.	K. & O. Ry. Co.	Q. C. Deed	Nov. 10, 1887	DB V35 P407	Nov 28, 1887	88 ~~2721~~	
13	The Sunday Creek Coal Co.	T. & O. C. Ry. Co.	W. Deed	Nov. 4, 1919	DB V95 P50	Mar. 26, 1920	77 2908	This deed also conveys parcels 24 to 26 inclusive, Map 101
11	Sarah Friel, et al	do	do	Dec. 27, 1922	DB V101 P242	Mar. 21, 1923	85 ~~2864~~	Completion Report No. 27-H
14	Bernard Doran, et al	do	do	Apr. 30, 1923	DB V107 P240	Aug. 19, 1926	86 ~~2947~~	" " No 4-0
10	John and Mary Amberge	do	do	Nov. 30, 1923	DB V103 P547	May 26, 1924	76 ~~2906~~	This is a part of parcel No. 22 Map 101 This deed also conveys parcels Nos. 18 to 22 inclusive, Map $\frac{VS}{25}$, and parcel No. 12, this Map
12	This parcel conveyed in same deed as parcel #10, this map.							
6A	The T. & O. C. Ry Co.	Wm. N. Wilson	Q. C. Deed	Nov. 28, 1924			83 ~~2868~~	Completion Report No. 57K
6B	do	Irwin J. Ryan	do	do			82 ~~2867~~	do
6C	do	Joe Lombard	do	Sept. 14, 1931			81 ~~3074~~	Completion Report No. AD 14
6D, 10A 10B 10C, 13A	The T. & O. C. Ry. Co.	State of Ohio	do	Oct. 6, 1933	DB V120 P390	June 4, 1935	109	
15, 16	These parcels transferred from Val. Sec. 305, June 6, 1931,			Comp. Rep. W-38-139. A.F.E. 2445-2.				Formerly Map $\frac{V\text{-}305}{27}$, Parcels 27 and 28.
6E	The T. & O. C. Ry. Co.	Roscoe Underwood	S. W. Deed	Mar. 25, 1943			113	

New Map as of 12-31-30
Prepared 2-1-33

1947	No Change	1931	7-12-33
1948	11-9-49	1932	No Change
1949	No Change	1933	1-10-36
1950	do	1934	No Change
1951	do	1935	8-10-36
1952	do	1936	No Change
1953	do	1937	do
1954	do	1938	3-10-41
1955	5-14-57	1939	8-12-41
1956	No Change	1940	No Change
1957	8-12-58	1941	do
1958	No Change	1942	11-17-43
1959	3-9-60	1943	9-23-43
1960 1968	1-13-70	1944	No Change
		1945	do
		1946	do

# THIS PROPERTY WAS MERGED WITH
THE NEW YORK CENTRAL
RAILROAD COMPANY
JUNE 30, 1952
AUTHORIZED IN I. C. C. DOCKET NO. 17700
ORDER JUNE 18, 1952

RIGHT-OF-WAY AND TRACK MAP
# ~~THE TOLEDO AND OHIO CENTRAL RAILWAY~~
OPERATED BY
THE NEW YORK CENTRAL RAILROAD COMPANY
MAIN LINE
FROM STATION 9701+29.7 TO STATION 9724+72.5
SCALE 1"= 100'
AS OF DEC. 31 1930
OFFICE OF VALUATION ENGINEER, COLUMBUS, OHIO

CORRECTED AS OF JAN. 1 1931
OFFICE OF VALUATION ENGINEER, CLEVELAND, OHIO

1-1-'31 V.302 / 102

~~V.7a / 1~~

~~V.7 / 1~~

I HEREBY CERTIFY THAT THIS IS A CORRECT
MAP PREPARED FROM THE RECORDS OF THE
NEW YORK CENTRAL RAILROAD COMPANY.

DEC. 16, 1944
James C. Powell
ASSISTANT ENGINEER

Sheet No. 115 of 115 of the Toledo & Ohio Central Ry.

PERRY COUNTY
MONROE TOWNSHIP

8122005

V302 / 102

302-115

VS 3020 LC 8122 MP 197.0 - 197.5