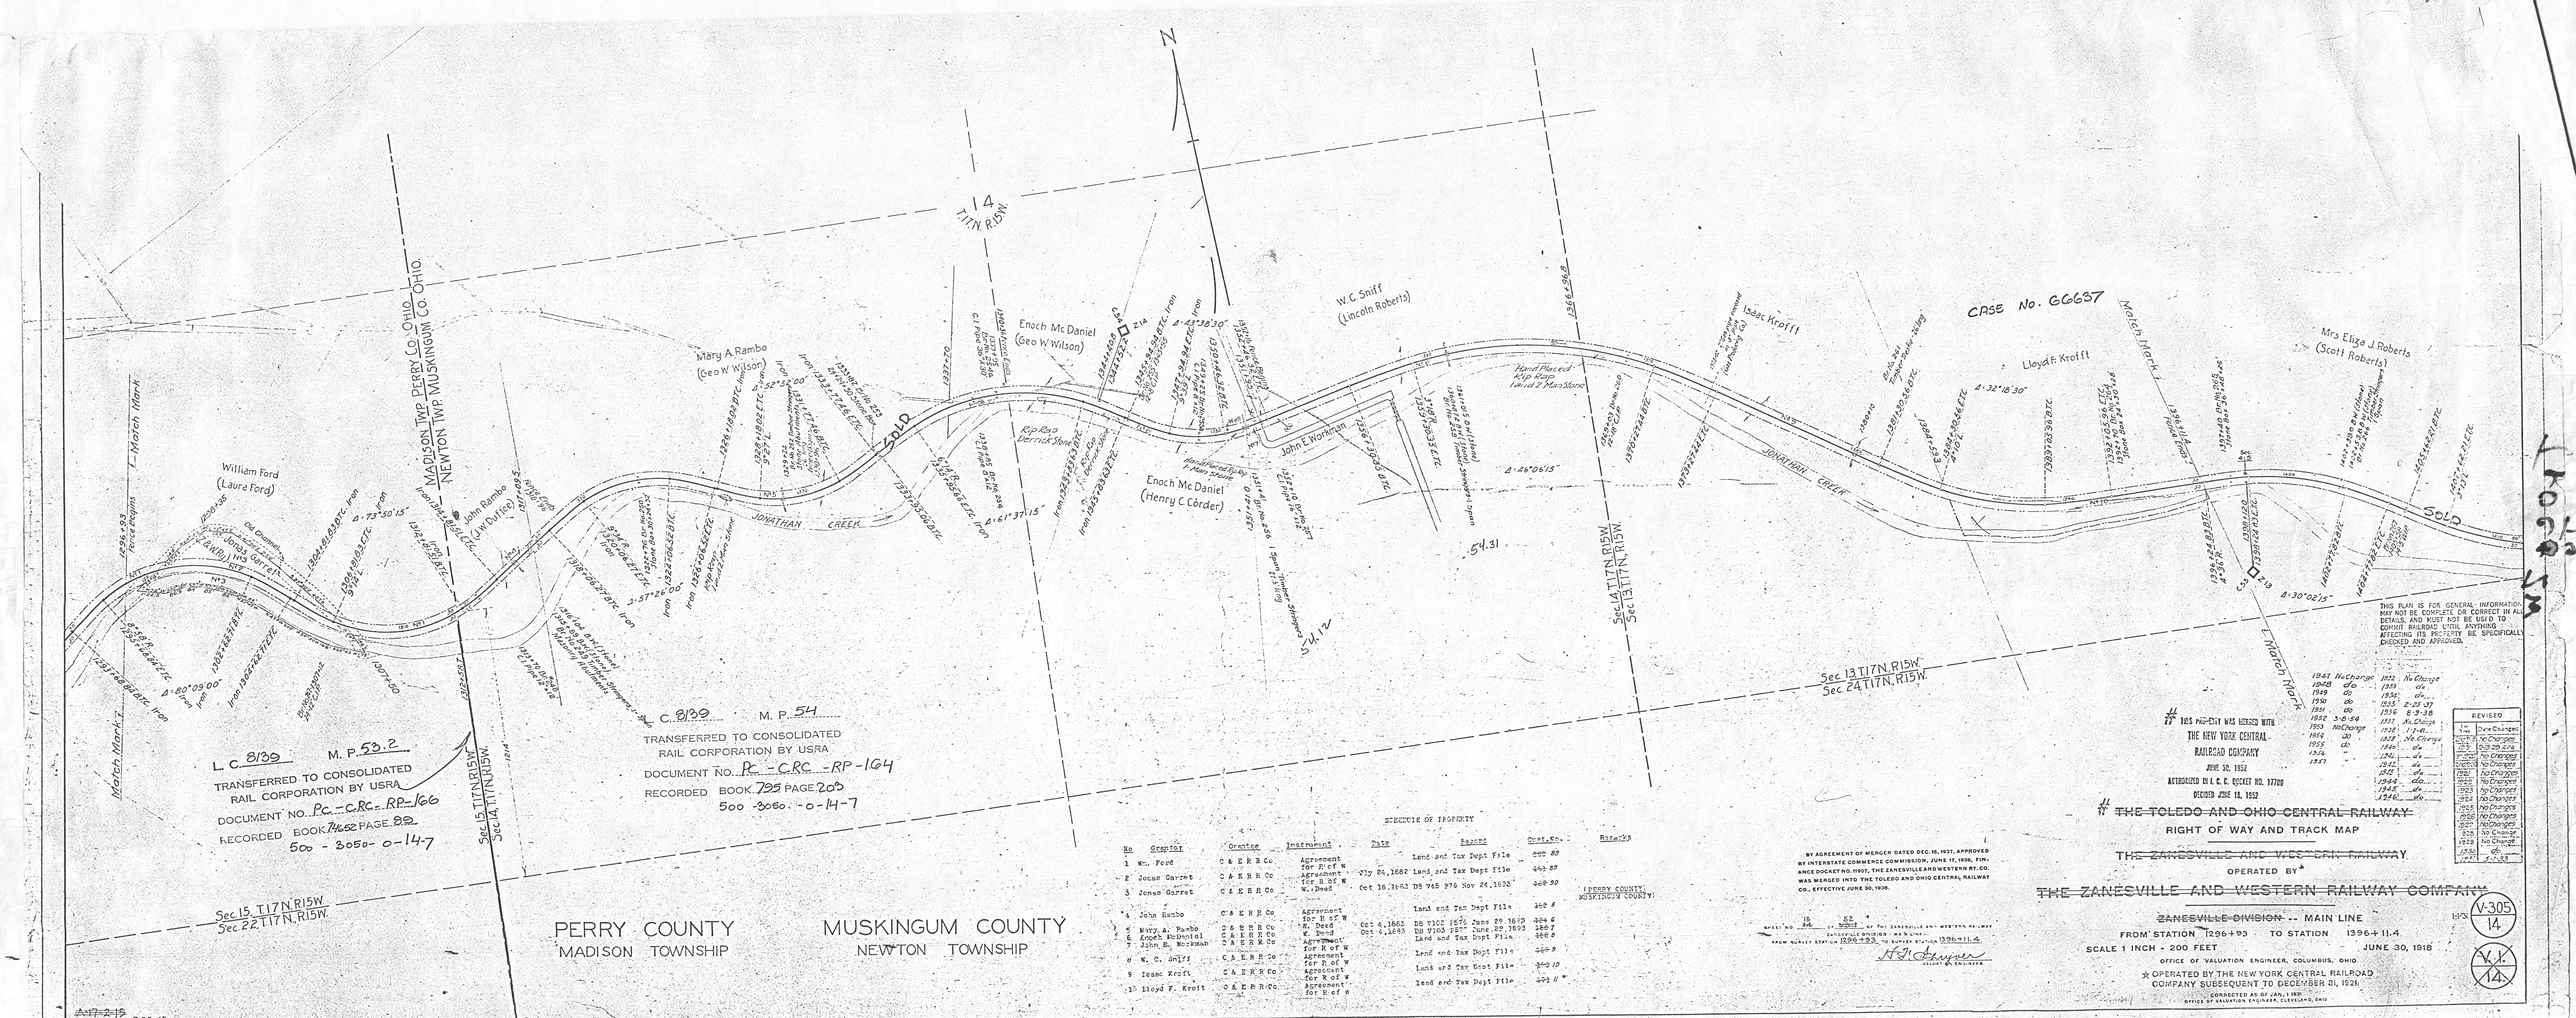


SCHEDULE OF PROPERTY

No	Grantor	Grantee	Instrument	Date	Reports	Orst. No.	Remarks
1	Wm. Ford	C & E R R Co	Agreement for R of W		Land and Tax Dept File	300 B8	
2	Jonas Garret	C & E R R Co	Agreement for R of W	July 24, 1882	Land and Tax Dept File	345 B9	
3	Jonas Garret	C & E R R Co	W. Deed	Oct 18, 1882	DB 945 P76 Nov 24, 1882	300 B0	(PERRY COUNTY, MUSKINGUM COUNTY)
4	John Rambo	C & E R R Co	Agreement for R of W		Land and Tax Dept File	300 B	
5	Mary A. Rambo	C & E R R Co	W. Deed	Oct 4, 1882	DB 9302 P572 June 29 1893	304 B	
6	Enoch McDaniel	C & E R R Co	W. Deed	Oct 4, 1882	DB 9303 P577 June 29 1893	186 B	
7	John E. Workman	C & E R R Co	Agreement for R of W		Land and Tax Dept Plats	300 B	
8	W. C. Sniff	C & E R R Co	Agreement for R of W		Land and Tax Dept Plats	300 B	
9	Isaac Krofft	C & E R R Co	Agreement for R of W		Land and Tax Dept File	300 B10	
10	Lloyd F. Krofft	C & E R R Co	Agreement for R of W		Land and Tax Dept File	300 B	

BY AGREEMENT OF MERGER DATED DEC. 16, 1937, APPROVED BY INTERSTATE COMMERCE COMMISSION, JUNE 17, 1938, FINANCE DOCKET NO. 11907, THE ZANESVILLE AND WESTERN RY. CO. WAS MERGED INTO THE TOLEDO AND OHIO CENTRAL RAILWAY CO., EFFECTIVE JUNE 30, 1938.

SHEET NO. 15 OF 52 SHEETS OF THE ZANESVILLE AND WESTERN RAILWAY
ZANESVILLE DIVISION - MAIN LINE
FROM SURVEY STATION 1296+93 TO SURVEY STATION 1396+11.4

N. F. Shryer
VALUATION ENGINEER

THIS PLAN IS FOR GENERAL INFORMATION, MAY NOT BE COMPLETE OR CORRECT IN ALL DETAILS, AND MUST NOT BE USED TO CONVEY RAILROAD UNTIL ANYTHING AFFECTING ITS PROPERTY MAY BE SPECIFICALLY CHECKED AND APPROVED.

1947	No Change	1932	No Change		
1948	do	1933	do		
1949	do	1934	do		
1950	do	1935	2-25-37		
1951	do	1936	8-3-38		
1952	3-8-54	1937	No Change		
1953	No Change	1938	7-1-41		
1954	do	1939	No Change		
1955	do	1940	do		
1956	"	1941	do		
1957	"	1942	do		
		1943	do		
		1944	do		
		1945	do		
		1946	do		

REVISED

1-44	Date Changed
1929	No Change
29-5	10-29-29
1930	No Change
1931	No Change
1932	No Change
1933	No Change
1934	No Change
1935	No Change
1936	No Change
1937	No Change
1938	No Change
1939	No Change
1940	No Change
1941	No Change
1942	No Change
1943	do
1944	4-1-53

THIS PROPERTY WAS MERGED WITH THE NEW YORK CENTRAL RAILROAD COMPANY JUNE 30, 1952 AUTHORIZED IN I. C. C. DOCKET NO. 17799 DECIDED JUNE 18, 1952

~~THE TOLEDO AND OHIO CENTRAL RAILWAY~~

RIGHT OF WAY AND TRACK MAP

~~THE ZANESVILLE AND WESTERN RAILWAY~~

OPERATED BY *

~~THE ZANESVILLE AND WESTERN RAILWAY COMPANY~~

~~ZANESVILLE DIVISION~~ -- MAIN LINE

FROM STATION 1296+93 TO STATION 1396+11.4

SCALE 1 INCH - 200 FEET JUNE 30, 1918

OFFICE OF VALUATION ENGINEER, COLUMBUS, OHIO

* OPERATED BY THE NEW YORK CENTRAL RAILROAD COMPANY SUBSEQUENT TO DECEMBER 31, 1921.

CORRECTED AS OF JAN. 1, 1951
OFFICE OF VALUATION ENGINEER, CLEVELAND, OHIO

V-305
14
V. V.
14.