All land Reverted

RSP

OWNER	VALUATION SECTION	SUB DIV.	SHEET NUMBER	REAL ESTATE REGION
500	3050	-	17B	7

SA

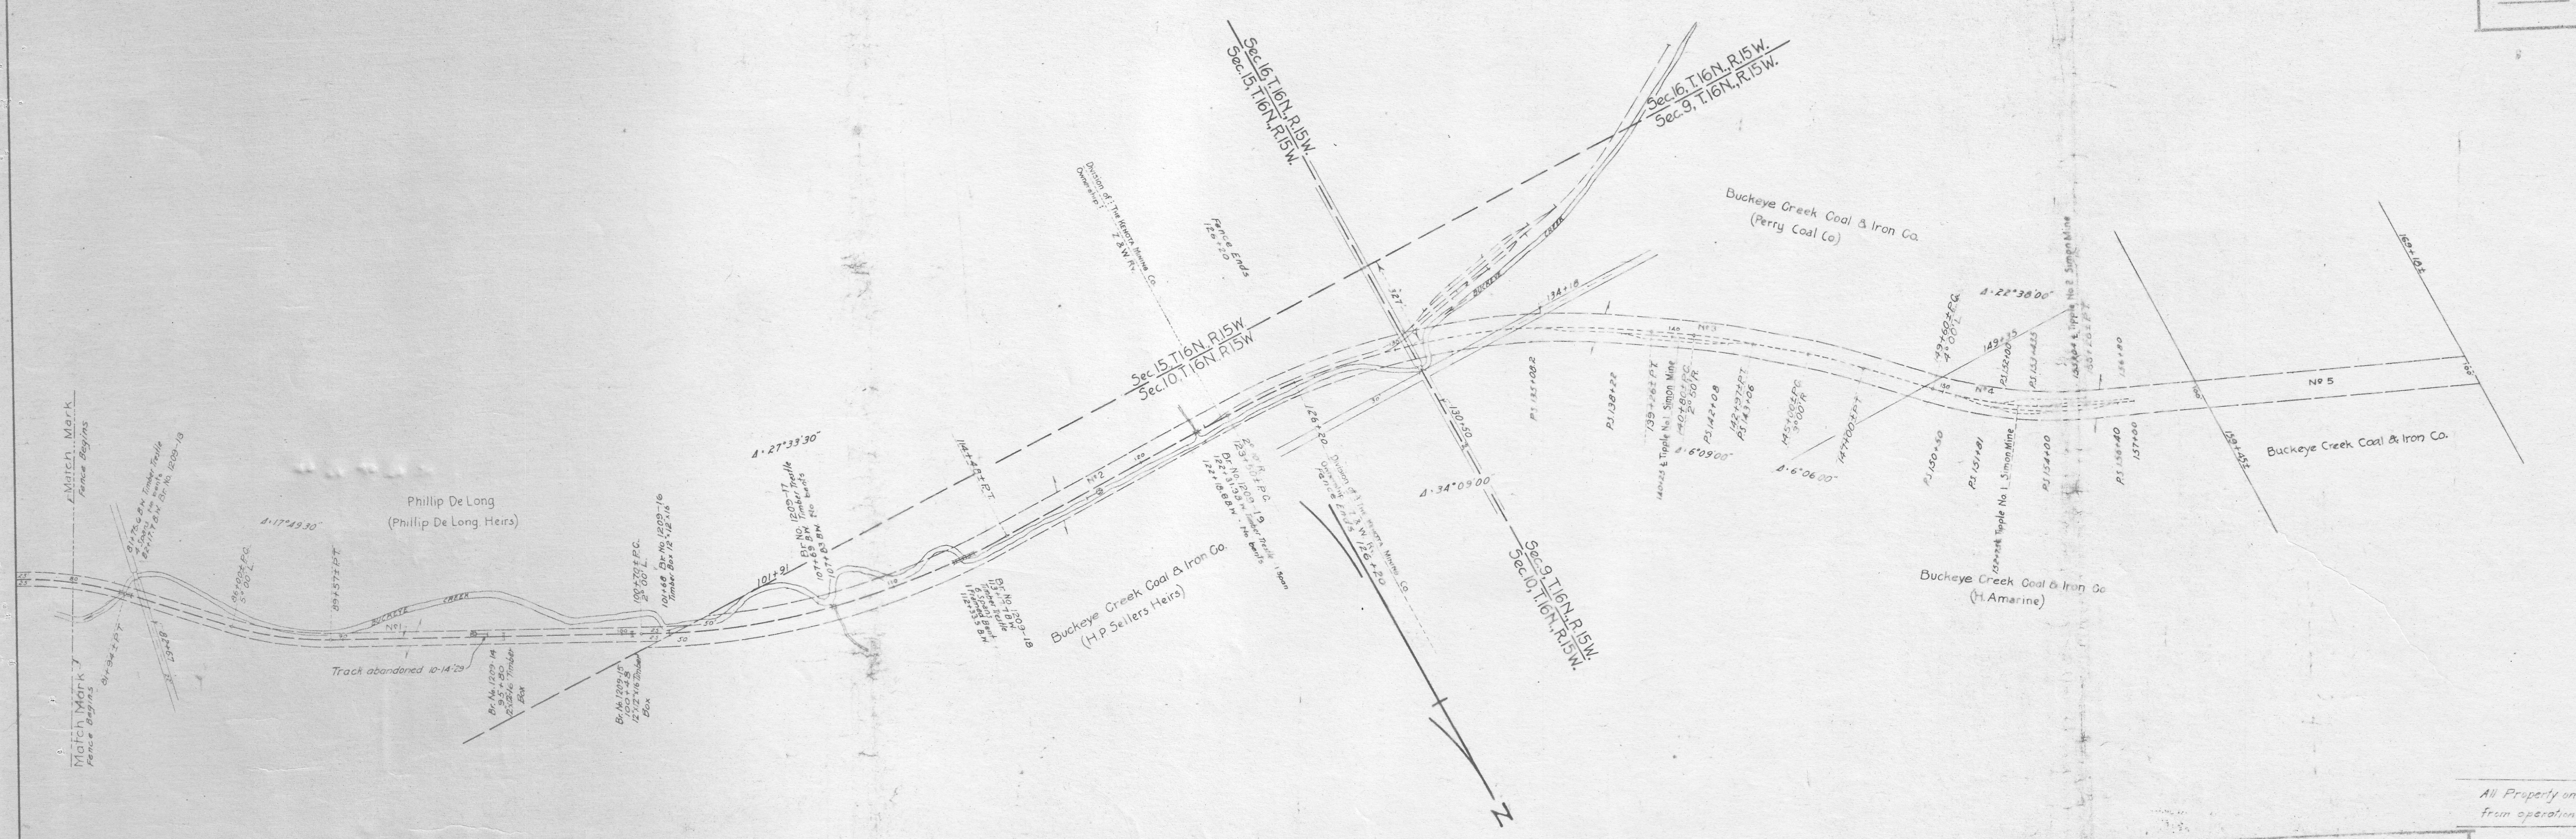
Match Mark
Fence Begins
81+75.6 B.W. Timber Trestle 4 Spans No bents 82+17.7 B.W. Br. No. 1209-13
81+94± P.T.
79+67
Δ·17°49'30"
86+00± P.C. 5°00' L.
89+57± P.T.
Phillip De Long
(Phillip De Long Heirs)
Buckeye Creek
Nº1
Track abandoned 10-14-'29
Br. No. 1209-14 95+80 12"x12"x16' Timber Box
100+70± P.C. 2°00' L.
101+68 Br. No. 1209-16 Timber Box 12"x12"x16'
Br. No. 1209-15 100+48 12"x12"x16' Timber Box
101+91
Br. No. 1209-17 Timber Trestle 107+69 B.W. No bents 107+83 B.W.
Δ·27°33'30"
114+48± P.T.
Br. No. 1209-18 113+17.7 B.W. Timber Trestle 6 Spans Bent 1 Framed Bent 112+33.5 B.W.
Buckeye Creek Coal & Iron Co.
(H.P. Sellers Heirs)
Nº2
Sec.15, T.16N., R.15W.
Sec.10, T.16N., R.15W.
2°00' R. 123+50± P.C.
Br. No. 1209-19 122+31.38 W. Timber Trestle 1 Span 122+18.88 W. No bents
Division of Ownership: The Kehota Mining Co. Z & W. Ry.
Fence Ends 126+20
126+20
Sec.16, T.16N., R.15W.
Sec.15, T.16N., R.15W.
327
130+50
Δ·34°09'00"
Sec.9, T.16N., R.15W.
Sec.10, T.16N., R.15W.
N
Sec.16, T.16N., R.15W.
Sec.9, T.16N., R.15W.
Buckeye Creek
134+18
Nº3
Buckeye Creek Coal & Iron Co.
(Perry Coal Co)
P.S. 135+08.2
P.S. 138+22
139+26± P.T.
140+25 ℄ Tipple No.1 Simon Mine
140+80± P.C. 2°50' R.
Δ·6°09'00"
P.S. 142+08
142+97± P.T.
P.S. 143+06
145+00± P.C. 3°00' R.
147+00± P.T.
Δ·6°06'00"
149+60± P.C. 4°00' L.
149+35
Δ·22°38'00"
Nº4
P.S. 150+50
P.S. 151+81
152+72± Tipple No.1 Simon Mine
P.S. 152+00
P.S. 153+435
153+04 ℄ Tipple No.2 Simon Mine
155+26± P.T.
P.S. 154+00
P.S. 156+40
156+80
157+00
Buckeye Creek Coal & Iron Co.
(H. Amarine)
159+45±
Nº5
169+18±
Buckeye Creek Coal & Iron Co.

REVISED	
For Year	Date Changed
1932	No Change
1933	do
1934	do
1935	do
1936	do
1937	do
1938	1-7-41
1939	No Change
1940	do
1941	10-28-42

REVISED	
For Year	Date Changed
2nd 1918	No Changes
1919	No Changes
1st 1920	No Changes
2nd 1920	1-21-29 RPG
1921	No Changes
1922	No Changes
1923	No Changes
1924	No Changes
1925	No Changes
1926	No Changes
1927	No Changes
1928	No Changes
1929	4-25-33 JHR
1930	No Changes
1931	5-1-33

All Property on this Map retired from operation 10-14-29.

THIS TRACING IS 50% ORIGINAL SIZE.
DRAFTSMAN TO DOUBLE SCALE

#THIS PROPERTY WAS MERGED WITH
THE NEW YORK CENTRAL
RAILROAD COMPANY
JUNE 30, 1952
AUTHORIZED IN I. C. C. DOCKET NO. 17700
DECIDED JUNE 18, 1952

~~#THE TOLEDO AND OHIO CENTRAL RAILWAY~~

RIGHT OF WAY AND TRACK MAP

~~THE ZANESVILLE AND WESTERN RAILWAY~~

OPERATED BY ★

~~THE ZANESVILLE AND WESTERN RAILWAY COMPANY~~

SHAWNEE DIVISION -- REDFIELD BRANCH
FROM STATION 80+00 TO STATION 169+18±
SCALE 1 INCH - 200 FEET JUNE 30, 1918
OFFICE OF VALUATION ENGINEER. COLUMBUS, OHIO

★ OPERATED BY THE NEW YORK CENTRAL RAILROAD
COMPANY SUBSEQUENT TO DECEMBER 31, 1926
CORRECTED AS OF JAN. 1 1931
OFFICE OF VALUATION ENGINEER, CLEVELAND, OHIO

1-1-31 V-305 / 17b

V.2 / 4.

BY AGREEMENT OF MERGER DATED DEC. 18, 1937, APPROVED BY INTERSTATE COMMERCE COMMISSION, JUNE 17, 1938, FINANCE DOCKET NO. 11907, THE ZANESVILLE AND WESTERN RY. CO. WAS MERGED INTO THE TOLEDO AND OHIO CENTRAL RAILWAY CO., EFFECTIVE JUNE 30, 1938.

SHEET NO ~~4~~ 28 OF ~~45-2~~ 57 OF THE ZANESVILLE AND WESTERN RAILWAY
SHAWNEE DIVISION - REDFIELD BRANCH
FROM SURVEY STATION 80+00 TO SURVEY STATION 169+18±
H. J. Schryver
VALUATION ENGINEER.

PERRY COUNTY
CLAYTON TOWNSHIP

SCHEDULE OF PROPERTY

No	Grantor	Grantee	Instrument	Date	Record	Cust No.	Remarks
1	Philip B. DeLong	C & E R R Co	Deed	Jly 1, 1886	DB V45 P53 Nov 18, 1893	~~387~~ 117	This is a part of parcel #21, Map 17a
2	The Buckeye Creek Coal & Iron Co	C & E R R Co	W. Deed	Aug 2, 1886	DB V45 P49-50 Nov 17, 1893	~~388~~ 118	
3	The Buckeye Creek Coal & Iron Co	C & E R R Co	W. Deed	Aug 2, 1886	DB V45 P50-51 Nov 17, 1893	~~389~~ 119	
4	The Buckeye Creek Coal & Iron Co	C & E R R Co	W. Deed	Aug 2, 1886	DB V45 P52-3 Nov 18, 1893	~~390~~ 120	
5	The Buckeye Creek Coal & Iron Co	C&E RR Co	W. Deed	Aug 2, 1886	DB V45 P48 Nov 17, 1893	~~391~~ 121	
1	T. & O.C. Ry. Co.	Palm Oil Corp.	Q. C. Deed	May 17, 1941		268	A.F.E. 50596
3	do	do	do	do		268	do
2,4,5	These parcels retired account defective title						do

~~A-17-3-5~~
305-28

~~A-17-3-5~~