ABAND. R-O-W "B" = 31.60 Ac. THIS SHEET
TOTAL = 66.39 Ac.

FOR AREA OF A SEE SHEET # 17-A

LC 8140

OWNER	VALUATION SECTION	SUB DIV.	SHEET NUMBER	REAL ESTATE REGION
500	3050	-	18	7

RSA

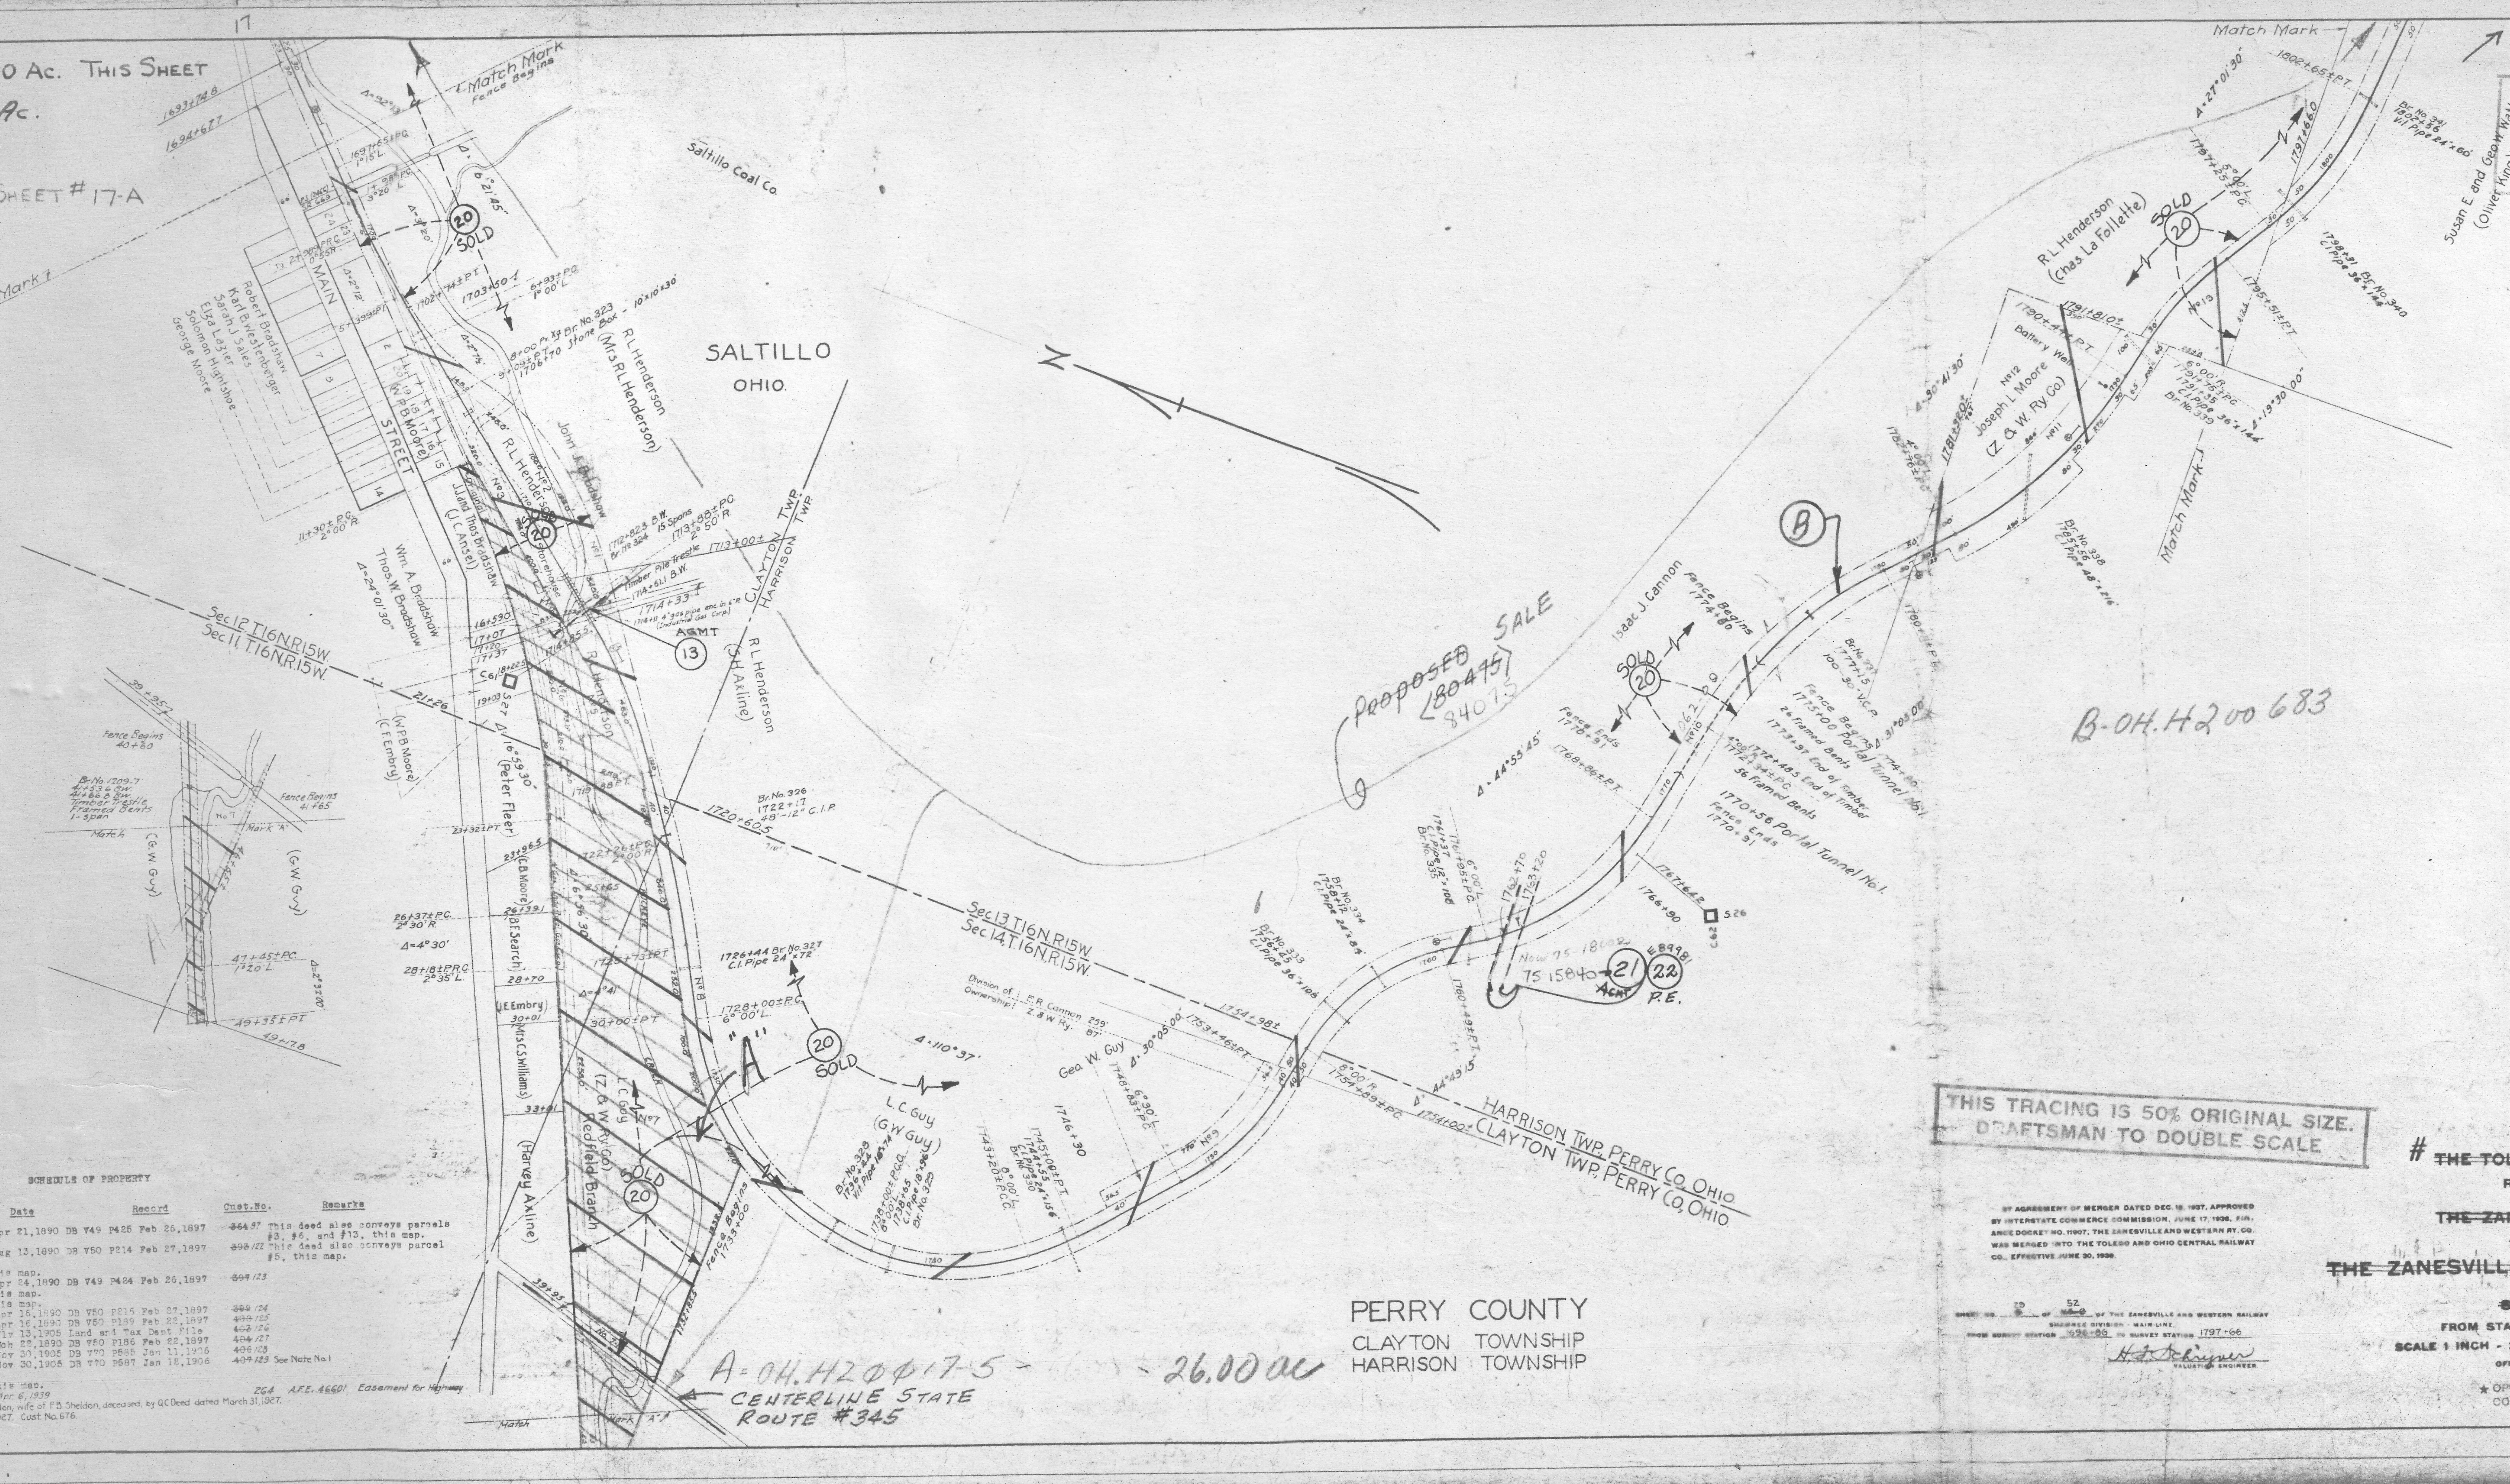

17
19
Match Mark
Fence Begins
Match Mark
Saltillo Coal Co.
SALTILLO
OHIO.
MAIN STREET
Robert Bradshaw
Karl B. Westenberger
Sarah J. Sales
Elza Lazier
Solomon Hightshoe
George Moore
(W.P.B. Moore)
R.L. Henderson
(Mrs. R.L. Henderson)
John J. Bradshaw
J.J. and Thos. Bradshaw
(J.C. Ansel)
Wm. A. Bradshaw
Thos. W. Bradshaw
Δ=24°01'30"
(C.F. Embry)
(Peter Fleer)
(C.B. Moore)
(B.F. Search)
(J.E. Embry)
Mrs. C.S. Williams
(Harvey Axline)
L.C. Guy
(Z. & W. Ry. Co.)
Redfield Branch
(S.H. Axline)
AGMT
13
SOLD
20
1703+50
1706+70 Stone Box - 10'x10'x30'
Br. No. 323
1712+82.3 B.W.
Br. No. 324
15 Spans
1713+88± P.C.
2° 50' R.
1713+00±
Timber Pile Trestle
1714+61.1 B.W.
1714+33
1714+11 4" gas pipe enc. in 6" P. (Industrial Gas Corp.)
CLAYTON TWP.
HARRISON TWP.
Sec. 12, T.16N., R.15W.
Sec. 11, T.16N., R.15W.
Sec. 13, T.16N., R.15W.
Sec. 14, T.16N., R.15W.
Br. No. 326
1722+17
48'-12" C.I.P.
1720+60.5
1726+44 Br. No. 327
C.I. Pipe 24"x72
1728+00± P.C.
6° 00' L.
"A"
Δ=110°37'
L.C. Guy
(G.W. Guy)
Geo. W. Guy
Division of Ownership: E.R. Cannon 259' Z. & W. Ry. 87'
Br. No. 328
1736+44
Vit. Pipe 18"x74
Br. No. 329
1738+65
C.I. Pipe 18"x96
Br. No. 330
1744+55
C.I. Pipe 24"x156
1746+30
1753+46± P.T.
1754+98±
1754+89± P.C.
6° 00' R.
1754+00±
Δ=30°05'00
Δ=44°49'15"
HARRISON TWP., PERRY CO., OHIO
CLAYTON TWP., PERRY CO., OHIO
Br. No. 333
1756+45
C.I. Pipe 36"x108
Br. No. 334
1758+12
C.I. Pipe 24"x84
Br. No. 335
1761+37
C.I. Pipe 12"x108
1760+49± P.T.
1762+70
1763+20
Now 75-18002
75 15840
AGMT
21
E 89981
22
P.E.
1766+90
1767+64.2
S.26
C 62
PROPOSED SALE
80475
84075
Isaac J. Cannon
Fence Begins
1774+80
Fence Ends
1770+91
1768+86± P.T.
Δ=44°55'45"
1770+56 Portal Tunnel No. 1
1772+48.5 End of Timber
1772+34± P.C.
56 Framed Bents
1773+97 End of Timber
26 Framed Bents
1775+00 Portal Tunnel No. 1
Br. No. 337
1777+15
100-30" V.C.P.
Δ=31°05'00
B
1780+11± P.T.
1782+76± P.C.
4° 00' L.
1781+92.0±
Δ=30°41'30"
Joseph L. Moore
(Z. & W. Ry. Co.)
Battery Well
1790+47± P.T.
1791+81.0±
Br. No. 338
1785+56
C.I. Pipe 48"x216
Br. No. 339
1791+35
C.I. Pipe 36"x144
1791+75± P.C.
6° 00' R.
Δ=19°30'00"
R.L. Henderson
(Chas. La Follette)
1795+51± P.T.
1797+25± P.C.
5° 00' L.
1797+66.0
Br. No. 340
1798+31
C.I. Pipe 36"x144
Δ=27°01'30"
1802+65± P.T.
Br. No. 341
1802+56
Vit. Pipe 24"x60"
Susan E. and Geo. W. Watts
(Oliver King)
Fence Begins 40+60
Br. No. 1209.7
41+53.6 B.W.
41+66.8 B.W.
Timber Trestle
Framed Bents
1-span
Fence Begins 41+65
Mark "A"
Match
(G.W. Guy)
(G.W. Guy)
47+45± P.C.
1°20' L.
Δ=2°32'00"
49+35± P.T.
49+17.8
39+95.7
Fence Begins
1733+00
1732+85.5
A = OH.H200 17-5
26.00 ac
B-OH.H200 683
CENTERLINE STATE ROUTE #345

SCHEDULE OF PROPERTY

No	Grantor	Grantee	Instrument	Date	Record	Cust.No.	Remarks
1	R. L. Henderson	C S & H Ry Co	W. Deed	Apr 21,1890	DB V49 P425 Feb 26,1897	~~364~~ 97	This deed also conveys parcels #3, #6, and #13, this map.
2	R. L. Henderson	C S & H Ry Co	W. Deed	Aug 13,1890	DB V50 P214 Feb 27,1897	~~393~~ 122	This deed also conveys parcel #5, this map.
3	This parcel conveyed in same deed as parcel #1, this map.						
4	John J. Bradshaw	C S & H Ry Co	W. Deed	Apr 24,1890	DB V49 P424 Feb 26,1897	~~397~~ 123	
5	This parcel conveyed in same deed as parcel #2, this map.						
6	This parcel conveyed in same deed as parcel #1, this map.			Apr 16,1890	DB V50 P215 Feb 27,1897	~~399~~ 124	
7	Luther C. Guy	C S & H Ry Co	W. Deed	Apr 16,1890	DB V50 P189 Feb 22,1897	~~402~~ 125	
8	Luther C. Guy	C S & H Ry Co	W. Deed	Jly 13,1905	Land and Tax Dept File	~~403~~ 126	
9	Geo. W. Guy	Z & W Ry Co	Deed	Mch 22,1890	DB V50 P186 Feb 22,1897	~~404~~ 127	
10	Isaac J. Cannon	C S & H Ry Co	W. Deed	Nov 30,1905	DB V70 P585 Jan 11,1906	~~406~~ 128	
11	Jos. L. Moore	Z & W Ry Co	W. Deed	Nov 30,1905	DB V70 P587 Jan 12,1906	~~407~~ 129	See Note No.1
12	Jos. L. Moore	F. B. Sheldon Trustee					
13	This parcel conveyed in same deed as parcel #1, this map.						
7-1	T. & O. C. Ry Co.	Board of County Com.	Easement	Apr. 6, 1939		264	A.F.E. 46601 Easement for Highway

Note No.1 - Conveyed to Z&W Ry. by Harriet E. Sheldon, wife of F.B. Sheldon, deceased, by QC Deed dated March 31, 1927. Recorded Vol. 108, Pg. 539, August 17, 1927. Cust. No. 676.

~~A-17-3-6~~
305-29

PERRY COUNTY
CLAYTON TOWNSHIP
HARRISON TOWNSHIP

THIS TRACING IS 50% ORIGINAL SIZE.
DRAFTSMAN TO DOUBLE SCALE

REVISED	
Year	Date Changed
1932	No Change
1933	do
1934	do
1935	do
1936	do
1937	do
1938	2-28-41
1939	9-15-41
1940	3-13-42
1941	3-1-43
1942	1-18-44
1943	No Change
1944	do
1945	do
1946	do

REVISED	
Year	Date Changed
1947	No Change
1948	do
1949	do
1950	do
1951	do
1952	do
1953	do
1954	do
1955	do
1956	"
1957	"
1958-68	9-2-70

REVISED	
For Year	Date Changed
2nd 1918	No Changes
1919	1-21-29 RPG
1st 1920	No Changes
2nd 1920	No Changes
1921	1-21-29 RPG
1922	No Changes
1923	No Changes
1924	1-21-29 RPG
1925	No Changes
1926	No Changes
1927	1-21-29 RPG
1928	No Changes
1929	6-17-31 B.H.
1930	6-11-31 B.H.
1931	5-1-33

# THIS PROPERTY WAS MERGED WITH
THE NEW YORK CENTRAL
RAILROAD COMPANY
JUNE 30, 1952
AUTHORIZED IN I. C. C. DOCKET NO. 17700
DECIDED JUNE 18, 1952

BY AGREEMENT OF MERGER DATED DEC. 18, 1937, APPROVED BY INTERSTATE COMMERCE COMMISSION, JUNE 17, 1938, FINANCE DOCKET NO. 11907, THE ZANESVILLE AND WESTERN RY. CO. WAS MERGED INTO THE TOLEDO AND OHIO CENTRAL RAILWAY CO., EFFECTIVE JUNE 30, 1938.

SHEET NO. 29 ~~9~~ OF 52 ~~16-0~~ OF THE ZANESVILLE AND WESTERN RAILWAY
SHAWNEE DIVISION - MAIN LINE
FROM SURVEY STATION 1696+86 TO SURVEY STATION 1797+66
H. F. Schryver
VALUATION ENGINEER

# ~~THE TOLEDO AND OHIO CENTRAL RAILWAY~~
RIGHT OF WAY AND TRACK MAP
~~THE ZANESVILLE AND WESTERN RAILWAY~~
OPERATED BY ★
~~THE ZANESVILLE AND WESTERN RAILWAY COMPANY~~
~~SHAWNEE DIVISION~~ -- MAIN LINE
FROM STATION 1696+86 TO STATION 1797+66
SCALE 1 INCH - 200 FEET JUNE 30, 1918
OFFICE OF VALUATION ENGINEER, COLUMBUS, OHIO.

★ OPERATED BY THE NEW YORK CENTRAL RAILROAD COMPANY SUBSEQUENT TO DECEMBER 31, 1921
CORRECTED AS OF JAN. 1 1931
OFFICE OF VALUATION ENGINEER, CLEVELAND, OHIO

1-1-31 V-305 / 18

V.2 / 5.

~~A-17-3-6~~

V6 P15 F2