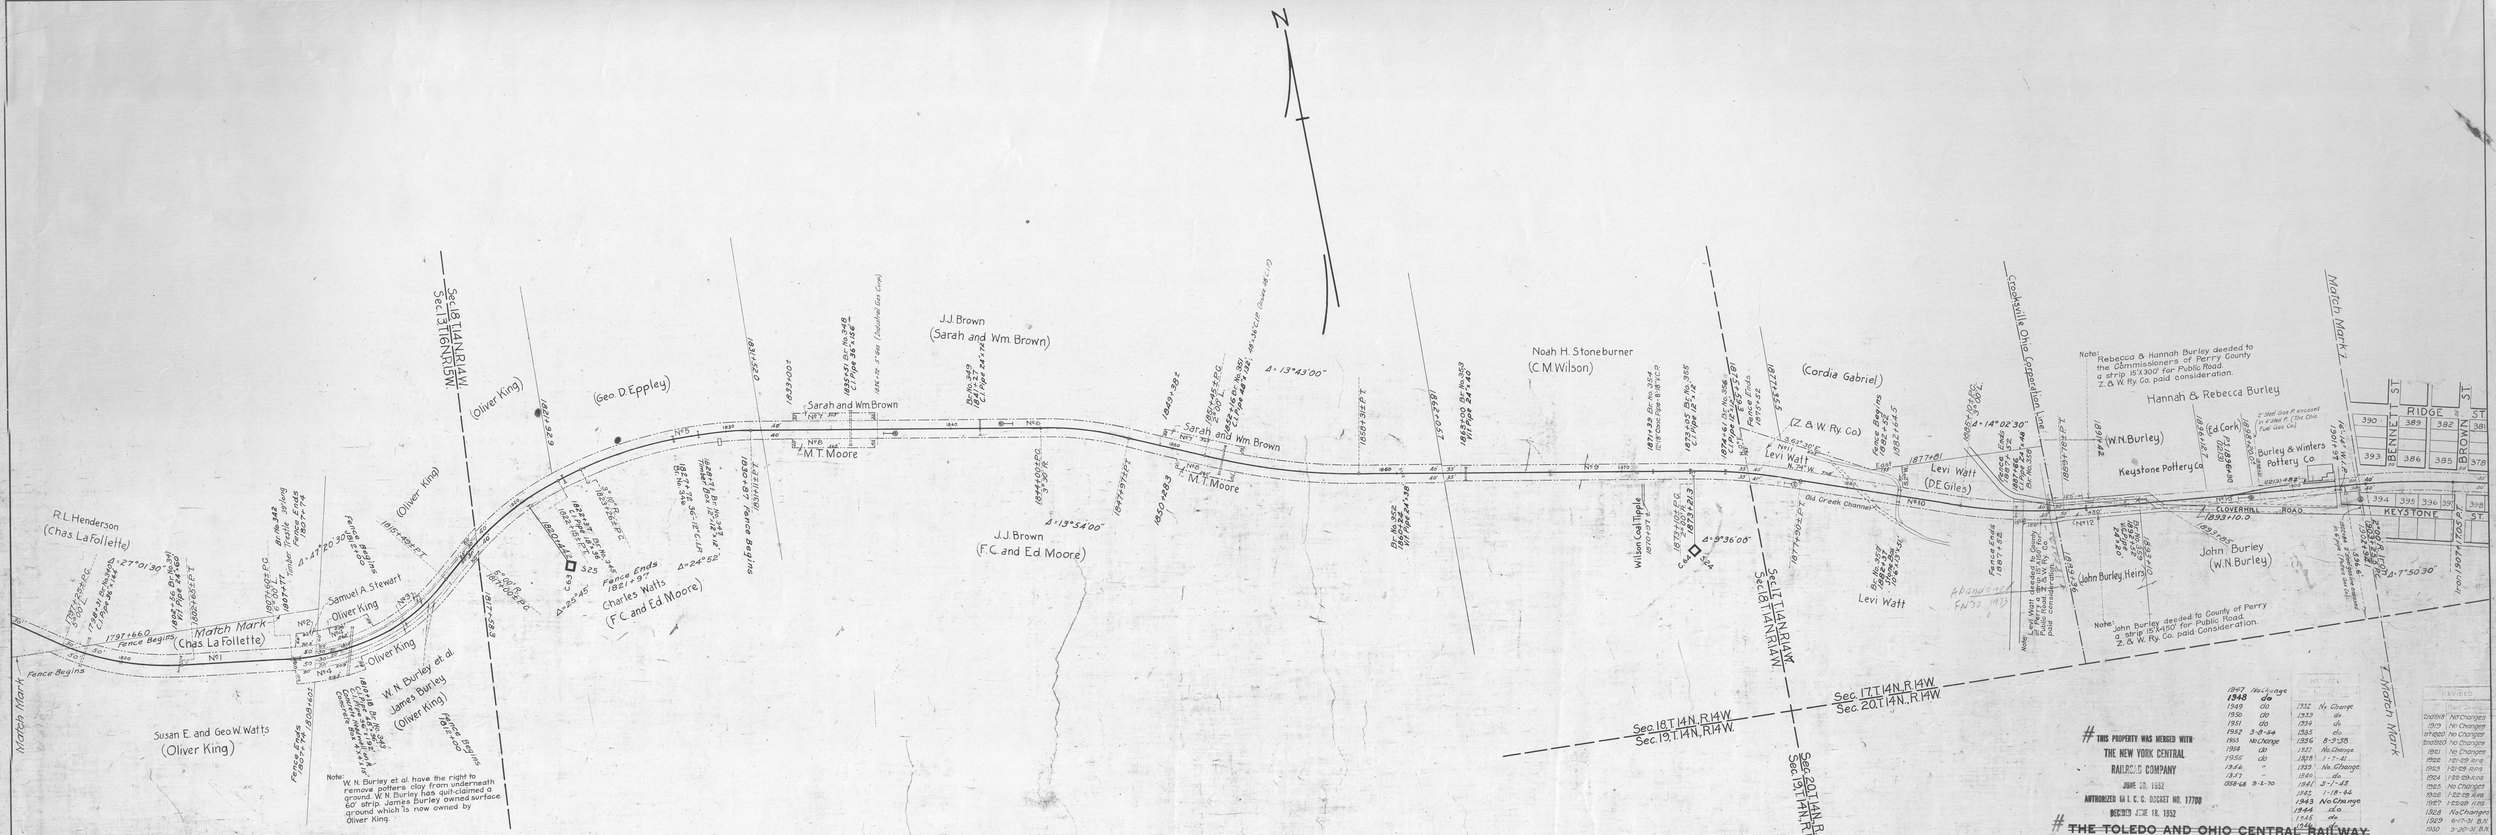


SCHEDULE OF PROPERTY

No.	Grantor	Grantee	Instrument	Date	Record	Dust No.	Remarks
1	Susan E. Watts	C S & H Ry Co	W. Deed	Apr 2, 1890	DB 749 P406	Feb 23, 1897	408 131
2	Samuel A. Stewart et al	Z & W Ry Co	W. Deed	June 14, 1902	DB 756 P300	June 29, 1909	436 132
3	James Burley	C S & H Ry Co	W. Deed	Mch 31, 1891	DB 750 P192	Feb 23, 1897	411 133
4	W.N. Burley, et al	C S & H Ry Co	C.-D. Deed	May 27, 1890	DB 750 P230	Feb 27, 1897	413 134
5	W.N. Burley, et al	C S & H Ry Co	C.-D. Deed	Dec 9, 1891	DB 745 P62	Nov 28, 1893	412 135
6	Oliver King	Z & W Ry Co	W. Deed	June 14, 1902	DB 756 P331	June 29, 1909	434 136
7	Charles Watts	C S & H Ry Co	W. Deed	June 11, 1891	DB 749 P450	Feb 23, 1897	409 137
8	James J. Brown	C S & H Ry Co	W. Deed	Aug 6, 1892	DB 745 P87	Nov 27, 1893	439 138
9	William H. Brown	Z & W Ry Co	W. Deed	Apr 28, 1904	DB 766 P375	May 2, 1904	433 139
10	M.T. Moore, et al	C S & H Ry Co	W. Deed	Apr 28, 1904	DB 766 P397	May 2, 1904	432 140
11	Noah E. Stoneburner	C S & H Ry Co	W. Deed	Apr 28, 1891	DB 760 P196	Feb 23, 1897	428 141
12	Levi Watt	C S & H Ry Co	W. Deed	Mch 21, 1892	DB 749 P407	Feb 24, 1897	429 142
13	Levi Watt	Z & W Ry Co	W. Deed	July 3, 1906	DB 771 P484	July 6, 1906	430 143
14	John Burley	C S & H Ry Co	W. Deed	Apr 1, 1892	DB 745 P402	Feb 25, 1897	435 144
15	Rebecca and Hannah Burley	C S & H Ry Co	W. Deed	Apr 1, 1892	DB 749 P404	Feb 23, 1897	406 145

PERRY COUNTY
HARRISON TOWNSHIP

BY AGREEMENT OF MERGER DATED DEC. 15, 1937, APPROVED BY INTERSTATE COMMERCE COMMISSION, JUNE 17, 1938, FINANCE DOCKET NO. 11007, THE ZANESVILLE AND WESTERN RY. CO. WAS MERGED INTO THE TOLEDO AND OHIO CENTRAL RAILWAY CO., EFFECTIVE JUNE 30, 1938.

SHEET NO. 30 OF 52 SHEETS OF THE ZANESVILLE AND WESTERN RAILWAY
SHAWNEE DIVISION - MAIN LINE
FROM SURVEY STATION 1797+66 TO SURVEY STATION 1902+94.1

Neil Johnsen
VALUATION ENGINEER

THIS PROPERTY WAS MERGED WITH THE NEW YORK CENTRAL RAILROAD COMPANY JUNE 18, 1952
AUTHORIZED BY I.C.C. DOCKET NO. 17720
DECIDED JUNE 18, 1952

~~THE TOLEDO AND OHIO CENTRAL RAILWAY~~

RIGHT OF WAY AND TRACK MAP

~~THE ZANESVILLE AND WESTERN RAILWAY~~

OPERATED BY

~~THE ZANESVILLE AND WESTERN RAILWAY COMPANY~~

~~SHAWNEE DIVISION~~ -- MAIN LINE

FROM STATION 1797+66 TO STATION 1902+94.1

SCALE 1 INCH - 200 FEET JUNE 30, 1918

OFFICE OF VALUATION ENGINEER, COLUMBUS, OHIO

* OPERATED BY THE NEW YORK CENTRAL RAILROAD COMPANY SUBJECT TO DECISIONS CITED.

CORRECTED AS OF JAN. 1, 1931
OFFICE OF VALUATION ENGINEER, CLEVELAND, OHIO.

1947	No change
1948	do
1949	do
1950	do
1951	do
1952	3-8-54
1953	No Change
1954	do
1955	do
1956	"
1957	"
1958-68	8-2-70

1931	No Change
1932	do
1934	do
1935	do
1936	8-9-38
1937	No Change
1938	1-7-41
1939	No Change
1940	do
1941	3-1-43
1942	1-18-44
1943	No Change
1944	do
1945	do
1946	do

REVISED

1918	No Changes
1919	No Change
Int 1920	No Changes
Int 1920	No Change
1921	No Change
1922	10-29 Ins
1923	12-29 Ins
1924	12-29 Ins
1925	No Changes
1926	12-29 Ins
1927	12-29 Ins
1928	No Changes
1929	6-17-31 Ins
1930	3-20-31 Ins
1931	5-1-33

V-305
19
V.Z
6

A-1-37
305-39