
LC 8140

ABAND. R-O-W "A" = 22.04 Ac. THIS SHEET. TOTAL = 100.25 Ac.

VALUATION SUB SHEET REAL ESTATE
OWNER SECTION DIV. NUMBER REGION
SDW 3050 D 21

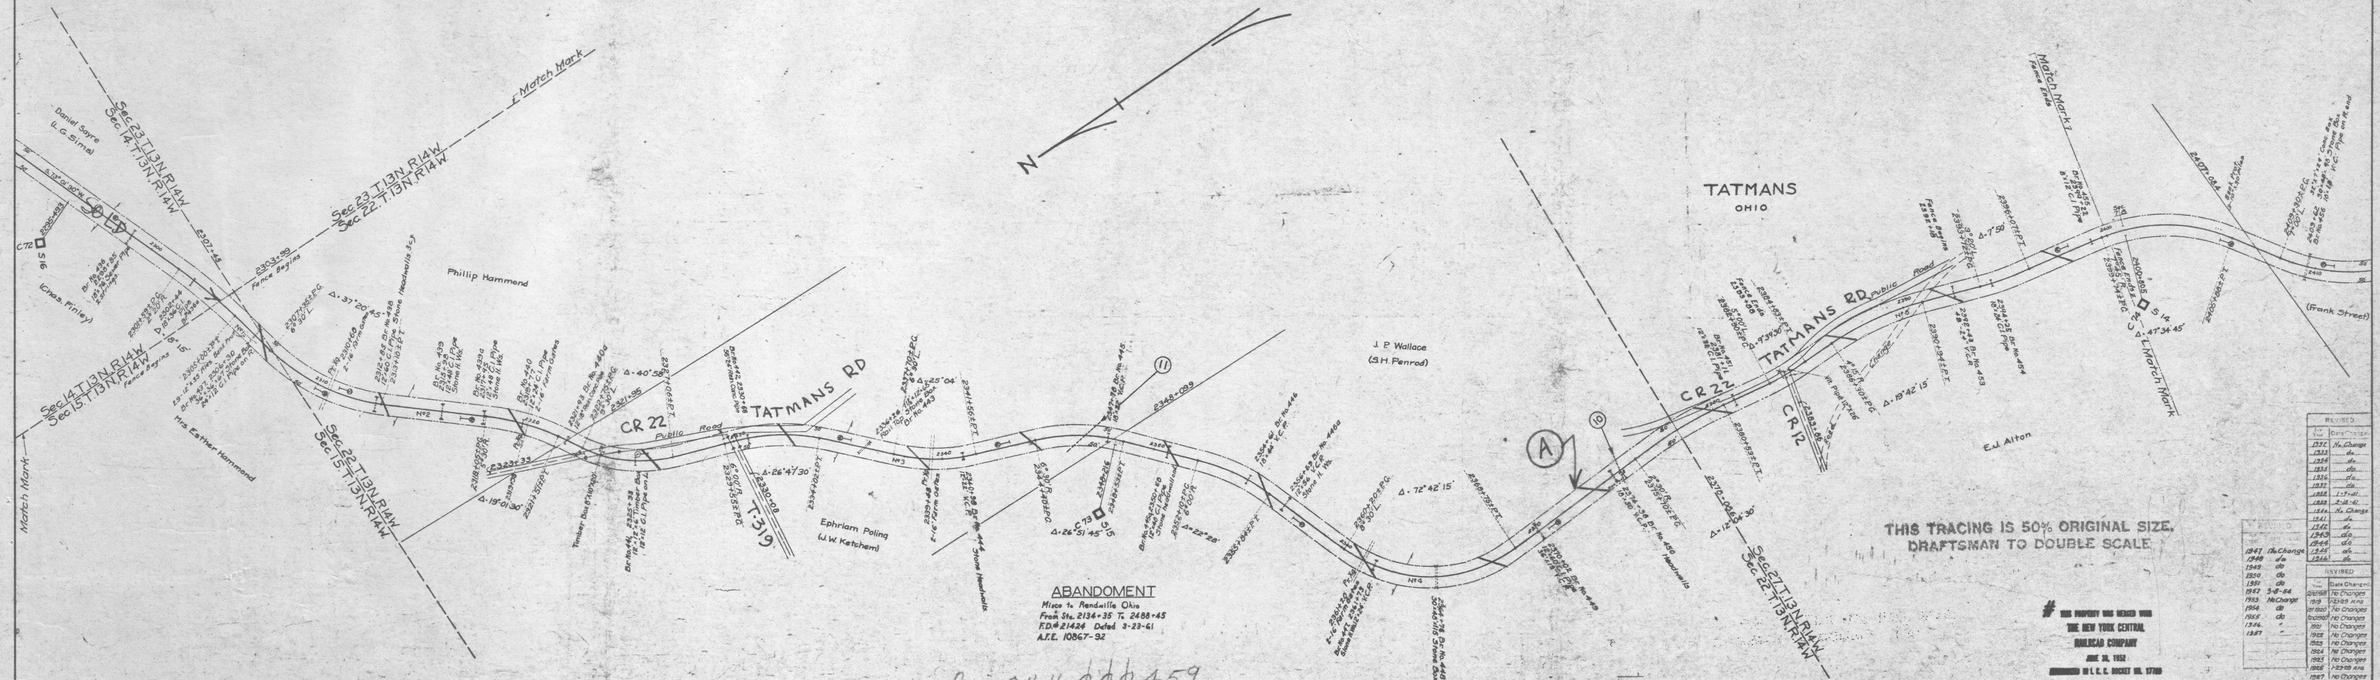

SCHEDULE OF PROPERTY

No	Grantor	Grantee	Instrument	Date	Record	Cost/Sq.	Remarks
1	Mrs. Esther Hammond	S & M R Ry Co	W. Deed	Oct 20,1887	DB V35 P531 Apr 4,1888	-66¢ /SF	
2	Philip Hammond	S & M R Ry Co	W. Deed	Oct 12,1887	DB V35 P536 Apr 4,1888	-66¢ /SF	
3	Zohrais Poling	S & M R Ry Co	W. Deed	Oct 20,1887	DB V36 P203 Apr 4,1888	-66¢ /SF	
4	J. P. Wallace	S & M R Ry Co	W. Deed	Oct 20,1887	DB V36 P279 Apr 4,1888	-66¢ /SF	
5	S. J. Alton	S & M R Ry Co	W. Deed	Oct 12,1887	DB V36 P [illegible] Apr 4,1888	-66¢ /SF	This parcel continued as parcel #1, Map 25

A-1-3-12
305-36

BY AGREEMENT OF MERGER DATED DEC. 15, 1927, APPROVED BY INTERSTATE COMMERCE COMMISSION, JUNE 17, 1926, FINANCE DOCKET NO. 19017, THE ZANESVILLE AND WESTERN RY. CO. WAS MERGED INTO THE TOLEDO AND OHIO CENTRAL RAILWAY CO., EFFECTIVE JUNE 30, 1926.

SHEET No. 35 OF 52 SHEETS OF THE ZANESVILLE AND WESTERN RAILWAY SHAWNEE DIVISION - MAIN LINE.
FROM SURVEY STATION 2303+99 TO SURVEY STATION 2400+00

Hal Skinner
VALUATION ENGINEER.

THIS TRACING IS 50% ORIGINAL SIZE.
DRAFTSMAN TO DOUBLE SCALE

THIS PROPERTY WAS MERGED WITH THE NEW YORK CENTRAL RAILROAD COMPANY JUNE 30, 1952 UNDER ORDER NO. 11 I.C.C. DOCKET NO. 17799 RECORDED JUNE 30, 1952

~~THE TOLEDO AND OHIO CENTRAL RAILWAY~~
RIGHT OF WAY AND TRACK MAP
~~THE ZANESVILLE AND WESTERN RAILWAY~~
OPERATED BY *
~~THE ZANESVILLE AND WESTERN RAILWAY COMPANY~~

~~SHAWNEE DIVISION~~ -- MAIN LINE
FROM STATION 2303+99 TO STATION 2400+00
SCALE 1 INCH - 200 FEET JUNE 30, 1918
OFFICE OF VALUATION ENGINEER, COLUMBUS, OHIO

* OPERATED BY THE NEW YORK CENTRAL RAILROAD COMPANY SUBSEQUENT TO DECEMBER 31, 1921
CORRECTED AS OF JAN. 1, 1929
OFFICE OF VALUATION ENGINEER, CLEVELAND, OHIO

REVISED	
No.	Date Changed
1357	No Change
1533	do.
1534	do.
1535	do.
1536	do.
1537	do.
1538	1-7-41
1588	2-28-41
1544	No Change
1541	do.
1542	do.
1543	do.
1545	do.
1547 No Change	do.
1548 do.	do.
1549 do.	do.
1550 do.	do.
1551 do.	do.
	No Changes
	No Changes
	No Changes
	No Changes
	1948 entry
	No Changes
	No Changes
	No Changes
	No Changes
1336	No Changes
1551	6-28-51

V-305
24
V2
11