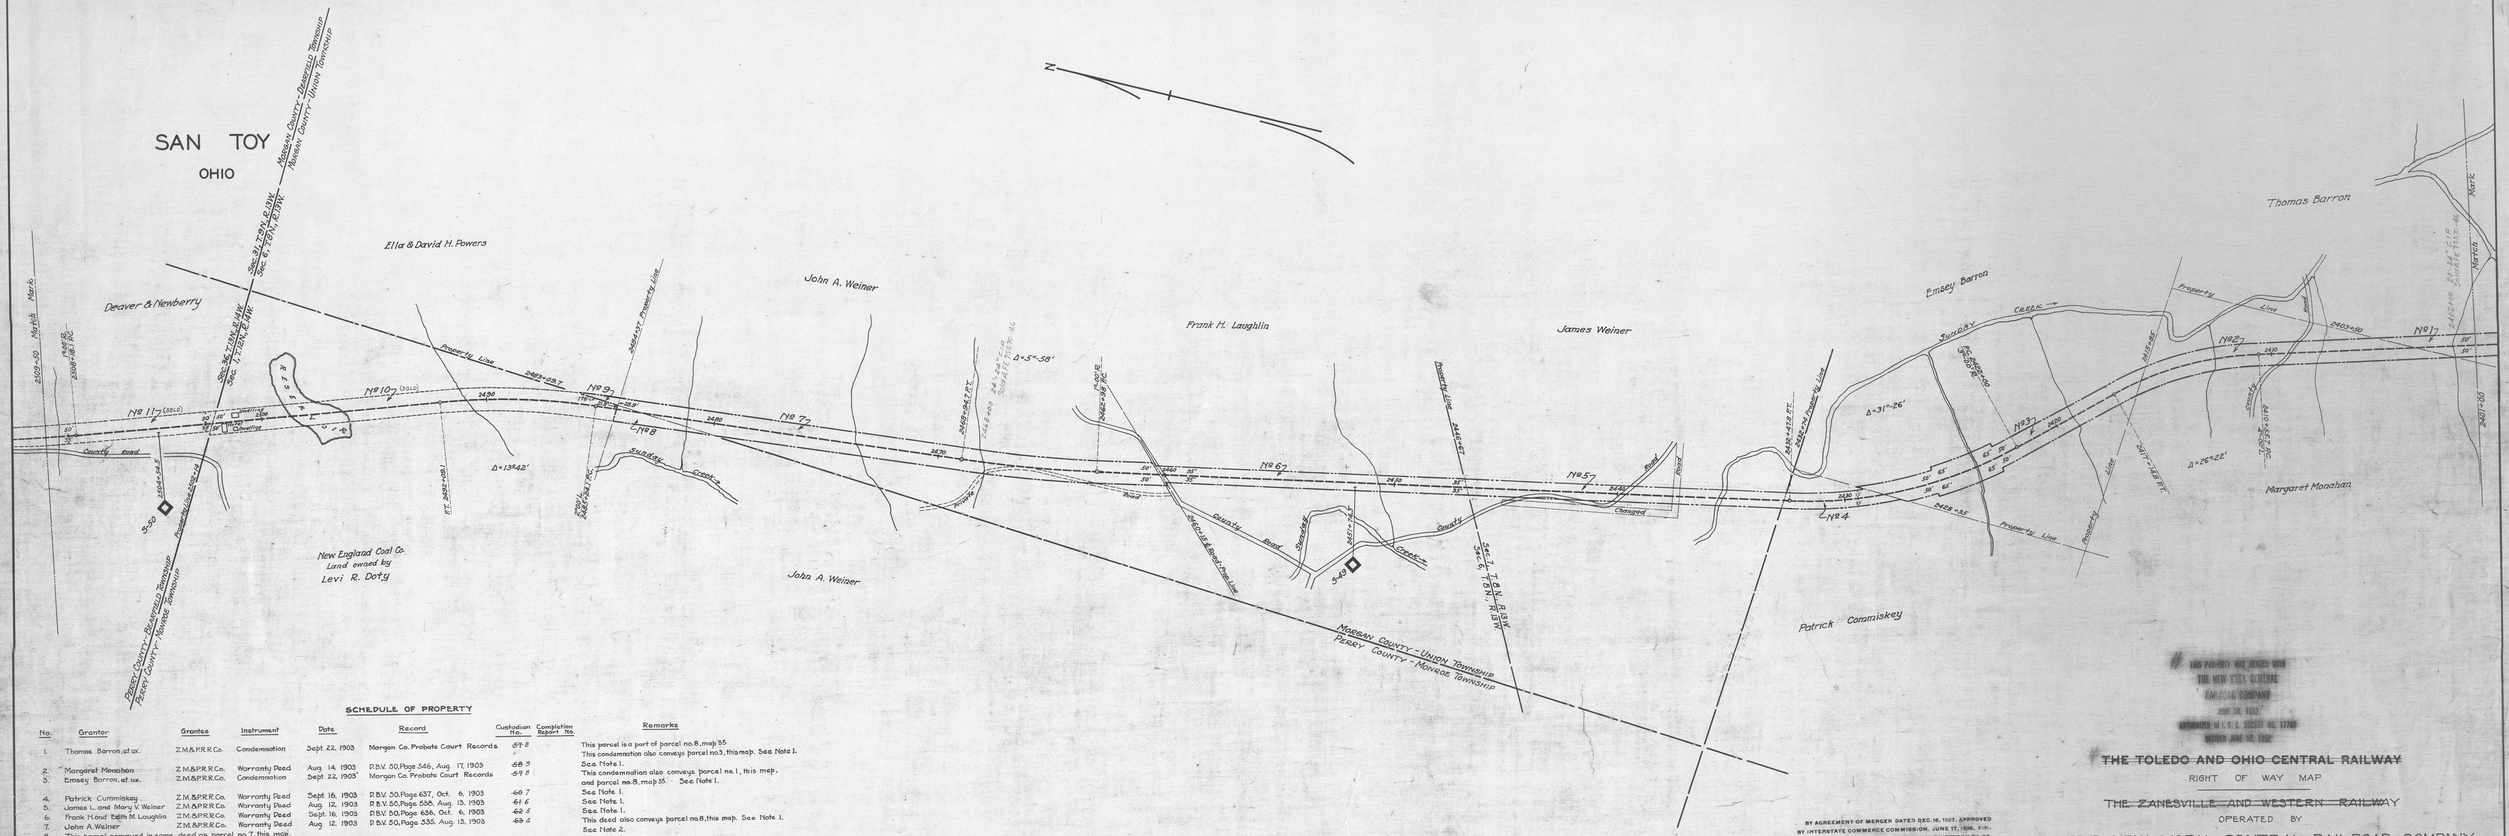



## SCHEDULE OF PROPERTY

| No. | Grantor | Grantee | Instrument | Date | Record | Custodian No. | Completion Report No. | Remarks |
|---|---|---|---|---|---|---|---|---|
| 1. | Thomas Barron, et ux. | Z.M.&P.R.R.Co. | Condemnation | Sept. 22, 1903 | Morgan Co. Probate Court Records | 67 8 | | This parcel is a part of parcel no.8, map 35. This condemnation also conveys parcel no.3, this map. See Note 1. |
| 2. | Margaret Monahan | Z.M.&P.R.R.Co. | Warranty Deed | Aug. 14, 1903 | P.B.V. 50, Page 546, Aug. 17, 1903 | 68 9 | | See Note 1. |
| 3. | Emsey Barron, et ux. | Z.M.&P.R.R.Co. | Condemnation | Sept. 22, 1903 | Morgan Co. Probate Court Records | 67 8 | | This condemnation also conveys parcel no.1, this map, and parcel no.8, map 35. See Note 1. |
| 4. | Patrick Cummiskey | Z.M.&P.R.R.Co. | Warranty Deed | Sept. 16, 1903 | P.B.V. 50, Page 637, Oct. 6, 1903 | 60 7 | | See Note 1. |
| 5. | James L. and Mary V. Weiner | Z.M.&P.R.R.Co. | Warranty Deed | Aug. 12, 1903 | P.B.V. 50, Page 556, Aug. 13, 1903 | 61 6 | | See Note 1. |
| 6. | Frank H. and Edith M. Laughlin | Z.M.&P.R.R.Co. | Warranty Deed | Sept. 16, 1903 | P.B.V. 50, Page 636, Oct. 6, 1903 | 62 5 | | See Note 1. |
| 7. | John A. Weiner | Z.M.&P.R.R.Co. | Warranty Deed | Aug. 12, 1903 | P.B.V. 50, Page 555, Aug. 13, 1903 | 63 4 | | This deed also conveys parcel no.8, this map. See Note 1. |
| 8. | This parcel conveyed in same deed as parcel no.7, this map. | | | | | | | See Note 2. |
| 9. | Ella and David H. Powers | Z.M.&P.R.R.Co. | Warranty Deed | Oct. 26, 1903 | P.B.V. 51, Page 127, Nov. 12, 1903 | 64 3 | | See Note 1. |
| 10. | Levi R. and Harriet L. Doty | Z.M.&P.R.R.Co. | Quit Claim Deed | May 23, 1904 | P.B.V. 54, Page 382, June 14, 1904 | 65 26 | | This deed also conveys parcel no.3, map 35. See Note 2. |
| 11. | Wm. Deaver, et al | Z.M.&P.R.R.Co. | Warranty Deed | Sept. 6, 1903 | P.B.V. 54, Page 145, Oct. 15, 1903 | 66 27 | | This parcel continued as parcel no.1, map 35. See Note 2. |

Note 1:- Parcels nos. 1, 2, 3, 4, 5, 6, 7 and 9, conveyed to The Cleveland Trust Co. by the Z.M.&P.R.R.Co. by deed dated July 26, 1928; recorded in deed book Vol. 73, page 257, Sept. 22, 1928, Custodian No. 678. Completion Report Z.&W.Ry. No. W-17.

Note 2:- Parcels nos. 8, 10, and 11, conveyed to The Cleveland Trust Co. by the Z.M.&P.R.R.Co. by deed dated July 26, 1928; recorded in deed book Vol. 110, page 411 to 419 inclusive, Sept. 17, 1928, Custodian No. 677. Completion Report Z.&W.Ry. No. W-17.

PERRY COUNTY
BEARFIELD TOWNSHIP
MONROE TOWNSHIP

MORGAN COUNTY
UNION TOWNSHIP

BY AGREEMENT OF MERGER DATED DEC. 16, 1927, APPROVED BY INTERSTATE COMMERCE COMMISSION, JUNE 17, 1928, FIN-ANCE DOCKET NO. 11607, THE ZANESVILLE AND WESTERN RY. CO. WAS MERGED INTO THE TOLEDO AND OHIO CENTRAL RAILWAY CO., EFFECTIVE JUNE 30, 1928.

SHEET NO. 45 OF 52 SHEETS OF THE ZANESVILLE AND WESTERN RAILWAY
FROM Z.M.&P.R.R. STATION 2401+00 TO Z.M.&P.R.R. STATION 2509+50
A. L. Miller
VALUATION ENGINEER

THIS PROPERTY WAS MERGED WITH THE NEW YORK CENTRAL RAILROAD COMPANY JUNE 30, 1952 AUTHORIZED I.C.C. DOCKET NO. 17799 RECORDED JUNE 18, 1952

~~THE TOLEDO AND OHIO CENTRAL RAILWAY~~

RIGHT OF WAY MAP

~~THE ZANESVILLE AND WESTERN RAILWAY~~

OPERATED BY

THE NEW YORK CENTRAL RAILROAD COMPANY

RIGHT OF WAY PURCHASED FROM

THE ZANESVILLE, MARIETTA AND PARKERSBURG RAILROAD COMPANY

FROM Z.M.&P.R.R. STATION 2401+00 TO Z.M.&P.R.R. STATION 2509+50

SCALE: 1 INCH = 200 FEET JULY 26, 1928

OFFICE OF CHIEF ENGINEER, COLUMBUS, OHIO

V-305 34 V-2 26

CORRECTED AS OF JAN. 1, 1931
OFFICE OF VALUATION ENGINEER, CLEVELAND, OHIO

A-17-3-27 305-45

500 3050-0 A-17-3-27