
ABAND. R-O-W "A" 26.88 Ac. THIS MAP ← TOTAL = 112.67 Ac.

"A" = OH H 000 842

VALUATION SUB SHEET | REAL ESTATE
OWNER | SECTION DIV. NUMBER | REGION
SDO | 3050 0 36

ALL PROPERTY SOLD
CASE NO. (88457)

THIS TRACING IS 50% ORIGINAL SIZE
DRAFTSMAN TO DOUBLE SCALE

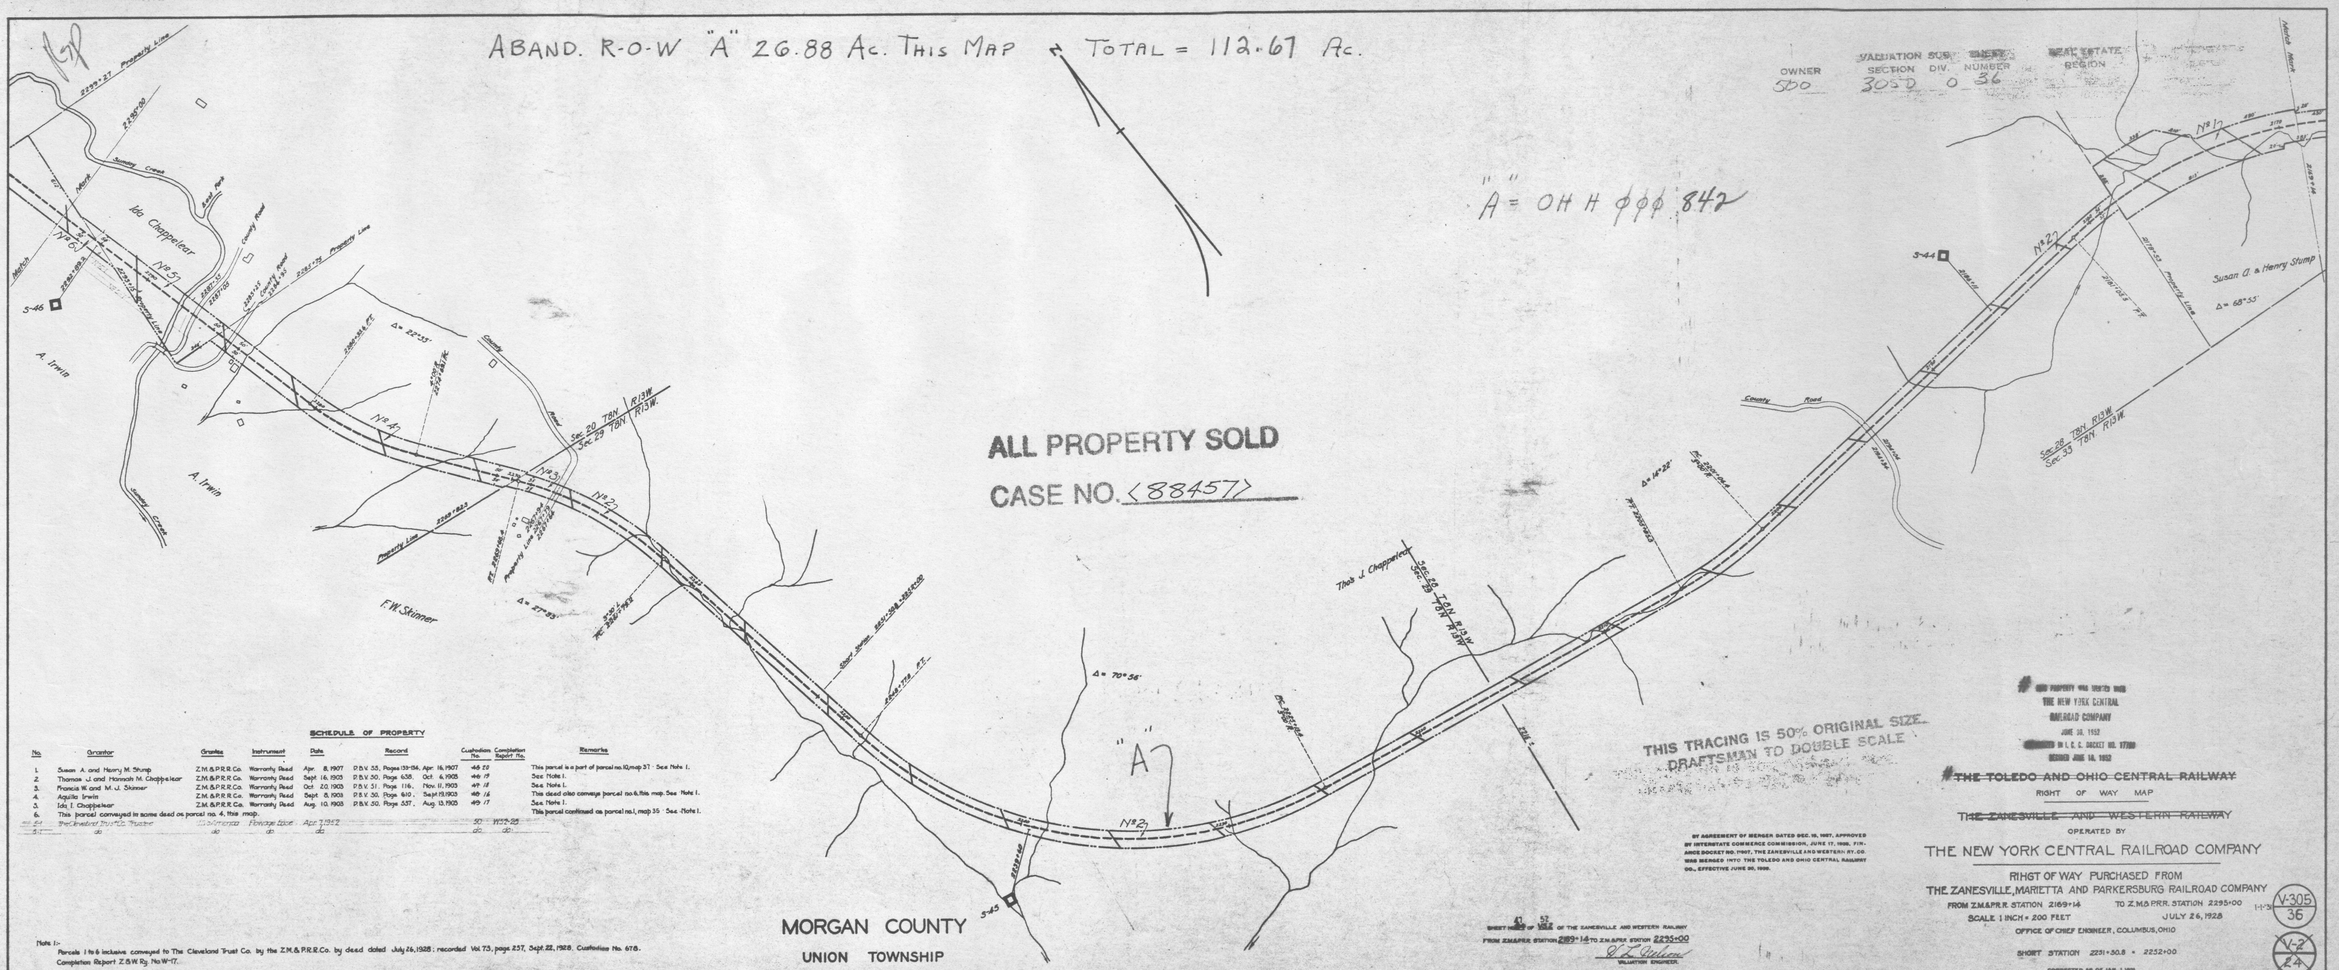

SCHEDULE OF PROPERTY

No.	Grantor	Grantee	Instrument	Date	Record	Cushotion No.	Completion Report No.	Remarks
1.	Susan A and Henry M. Stump	Z.M.&P.R.R.Co.	Warranty Deed	Apr. 8, 1907	D.B.V. 55, Pages 139-194, Apr. 16, 1907	46-18		This parcel is a part of parcel no.10,map 37 - See Note 1.
2.	Thomas J. and Hannah M. Chappelear	Z.M.&P.R.R.Co.	Warranty Deed	Sept. 16, 1903	D.B.V. 50, Page 638, Oct. 6, 1903	46-19		See Note 1.
3.	Francis W. and M. J. Skinner	Z.M.&P.R.R.Co.	Warranty Deed	Oct. 20, 1903	D.B.V. 51, Page 116, Nov. 11, 1903	49-14		See Note 1.
4.	Aquilla Irwin	Z.M.&P.R.R.Co.	Warranty Deed	Sept. 8, 1903	D.B.V. 50, Page 610, Sept. 15, 1903	49-16		This deed also conveys parcel no.6,this map. See Note 1.
5.	Ida J. Chappelear	Z.M.&P.R.R.Co.	Warranty Deed	Aug. 10, 1903	D.B.V. 50, Page 537, Aug. 13, 1903	49-17		See Note 1.
6.	This parcel conveyed in same deed as parcel no. 4, this map.							This parcel continued as parcel no.1, map 35 - See Note 1.
7.	The Cleveland Trust Co. Trustee	to Monroe Fenoge Etux		Apr. 7 1942		50	1172-38	
8.	do	do	do	do	do	do	do	

Note 1:-
Parcels 1 to 6 inclusive conveyed to The Cleveland Trust Co. by the Z.M.& P.R.R.Co. by deed dated July 26, 1928; recorded Vol. 73, page 257, Sept. 22, 1928. Cushotion No. 678.
Completion Report Z.& W. Ry. No. W-17.

MORGAN COUNTY
UNION TOWNSHIP

BY AGREEMENT OF MERGER DATED DEC. 10, 1907, APPROVED BY INTERSTATE COMMERCE COMMISSION, JUNE 17, 1908, FINANCE DOCKET NO. 1907, THE ZANESVILLE AND WESTERN RY. CO. WAS MERGED INTO THE TOLEDO AND OHIO CENTRAL RAILWAY CO., EFFECTIVE JUNE 20, 1908.

FROM Z.M.&P.R. STATION 2169+14 TO Z.M.&P.R. STATION 2295+00
O. L. Gilliland
VALUATION ENGINEER.

THIS PROPERTY WAS VESTED IN
THE NEW YORK CENTRAL
RAILROAD COMPANY
JUNE 30, 1952
BY DECREE IN I. C. C. DOCKET NO. 17380
DECREED JUNE 16, 1952

~~THE TOLEDO AND OHIO CENTRAL RAILWAY~~
RIGHT OF WAY MAP
~~THE ZANESVILLE AND WESTERN RAILWAY~~
OPERATED BY
THE NEW YORK CENTRAL RAILROAD COMPANY
RIHGT OF WAY PURCHASED FROM
THE ZANESVILLE, MARIETTA AND PARKERSBURG RAILROAD COMPANY
FROM Z.M.&P.R.R. STATION 2169+14 TO Z.M.&P.R.R. STATION 2295+00
SCALE 1 INCH = 200 FEET JULY 26, 1928
OFFICE OF CHIEF ENGINEER, COLUMBUS, OHIO
SHORT STATION 2231+30.8 = 2252+00

CORRECTED AS OF JAN. 1 1951
OFFICE OF VALUATION ENGINEER, CLEVELAND, OHIO

V-305
36
1-1-51
V-2
24

A=17-3-25 305-41

A=17-3-25