
SCHEDULE OF PROPERTY

No.	Grantor	Grantee	Instrument	Date	Record	Custodian No.	Remarks
1.	Sarah V. Dale	Z.M.& P.R.R.Co.	Warranty Deed	July 20, 1903	D.B.V.50, Page 520, Aug. 8, 1903	44-37	This parcel is a part of parcel no. 1, map 40 . See Note 1.
2.	Charles and Lydia Carpenter	Z.M.& P.R.R.Co.	Warranty Deed	Jan. 22, 1904	D.B.V.51, Page 328, Jan. 30, 1904	45-38	See Note 1.
3.	Charley S. and May Price	Z.M.& P.R.R.Co.	Warranty Deed	Oct. 20, 1903	D.B.V.51, Page 114 , Nov. 10, 1903	45-35	This deed also conveys parcel no. 1, on map 38 . See Not 1.

Note 1:-
Parcels nos. 1, 2 and 3 conveyed to The Cleveland Trust Co. by the Z.M.& P.R.R.Co. by deed dated July 26, 1928, recorded Vol. 73, page 257, Sept. 22, 1928. Custodian No. 678.
Completion Report Z.& W. Ry. No. W-17.

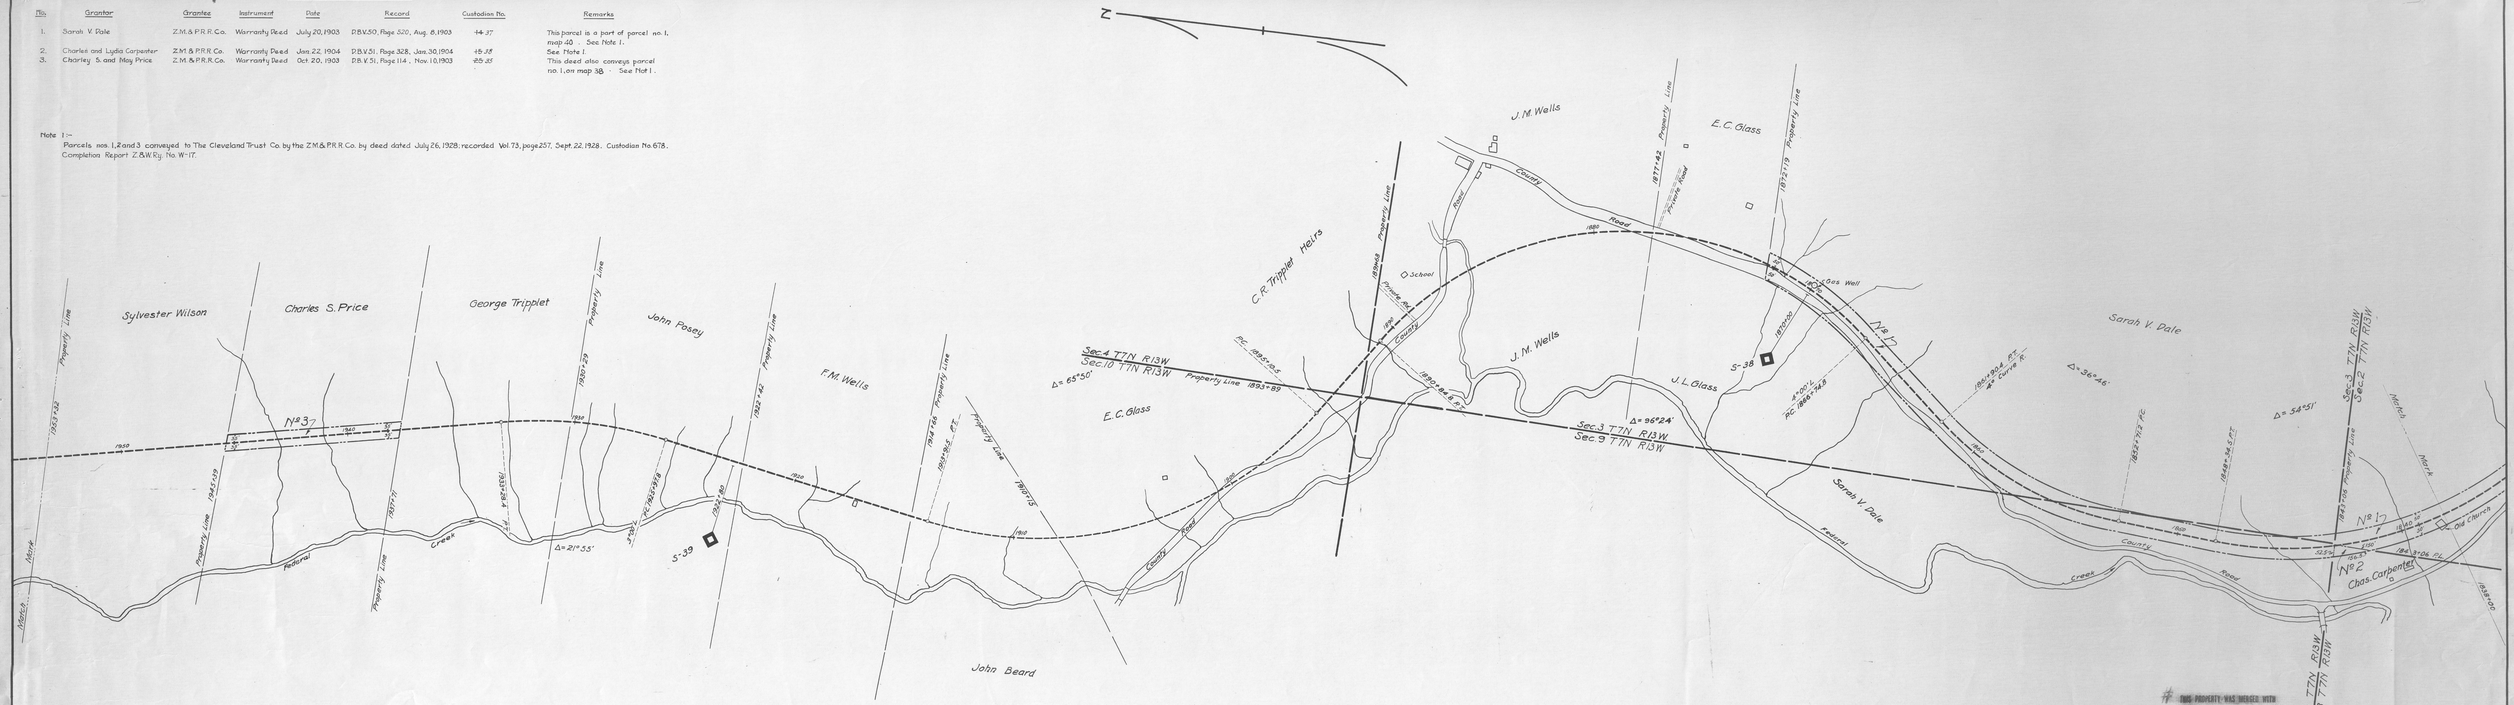

MORGAN COUNTY
HOMER TOWNSHIP

SHEET NO 21 OF 52 SHEETS OF THE ZANESVILLE AND WESTERN RAILWAY
FROM Z.M.& P.R.R. STATION 1838+00 TO Z.M.& P.R.R. STATION 1853+32
R. T. Wilson
VALUATION ENGINEER

BY AGREEMENT OF MERGER DATED DEC. 16, 1937, APPROVED BY INTERSTATE COMMERCE COMMISSION, JUNE 17, 1938, FINANCE DOCKET NO. 11907, THE ZANESVILLE AND WESTERN RY. CO. WAS MERGED INTO THE TOLEDO AND OHIO CENTRAL RAILWAY CO., EFFECTIVE JUNE 30, 1938.

THIS PROPERTY WAS MERGED WITH THE NEW YORK CENTRAL RAILROAD COMPANY JUNE 30, 1952
AUTHORIZED IN I. C. C. DOCKET NO. 17700
RECEIVED JUNE 30, 1952

~~THE TOLEDO AND OHIO CENTRAL RAILWAY~~
RIGHT OF WAY MAP
~~THE ZANESVILLE AND WESTERN RAILWAY~~
OPERATED BY
THE NEW YORK CENTRAL RAILROAD COMPANY
RIGHT OF WAY PURCHASED FROM
THE ZANESVILLE, MARIETTA AND PARKERSBURG RAILROAD COMPANY
FROM Z.M.& P.R.R. STATION 1838+00 TO Z.M.& P.R.R. STATION 1853+32
SCALE: 1 INCH = 200 FEET JULY 26, 1928
OFFICE OF CHIEF ENGINEER, COLUMBUS, OHIO

V-305 / 39
V-2 / 21

CORRECTED AS OF JAN. 1 1931
OFFICE OF VALUATION ENGINEER, CLEVELAND, OHIO

305-50
A-17-3-22

500 3050 A-17-3-22