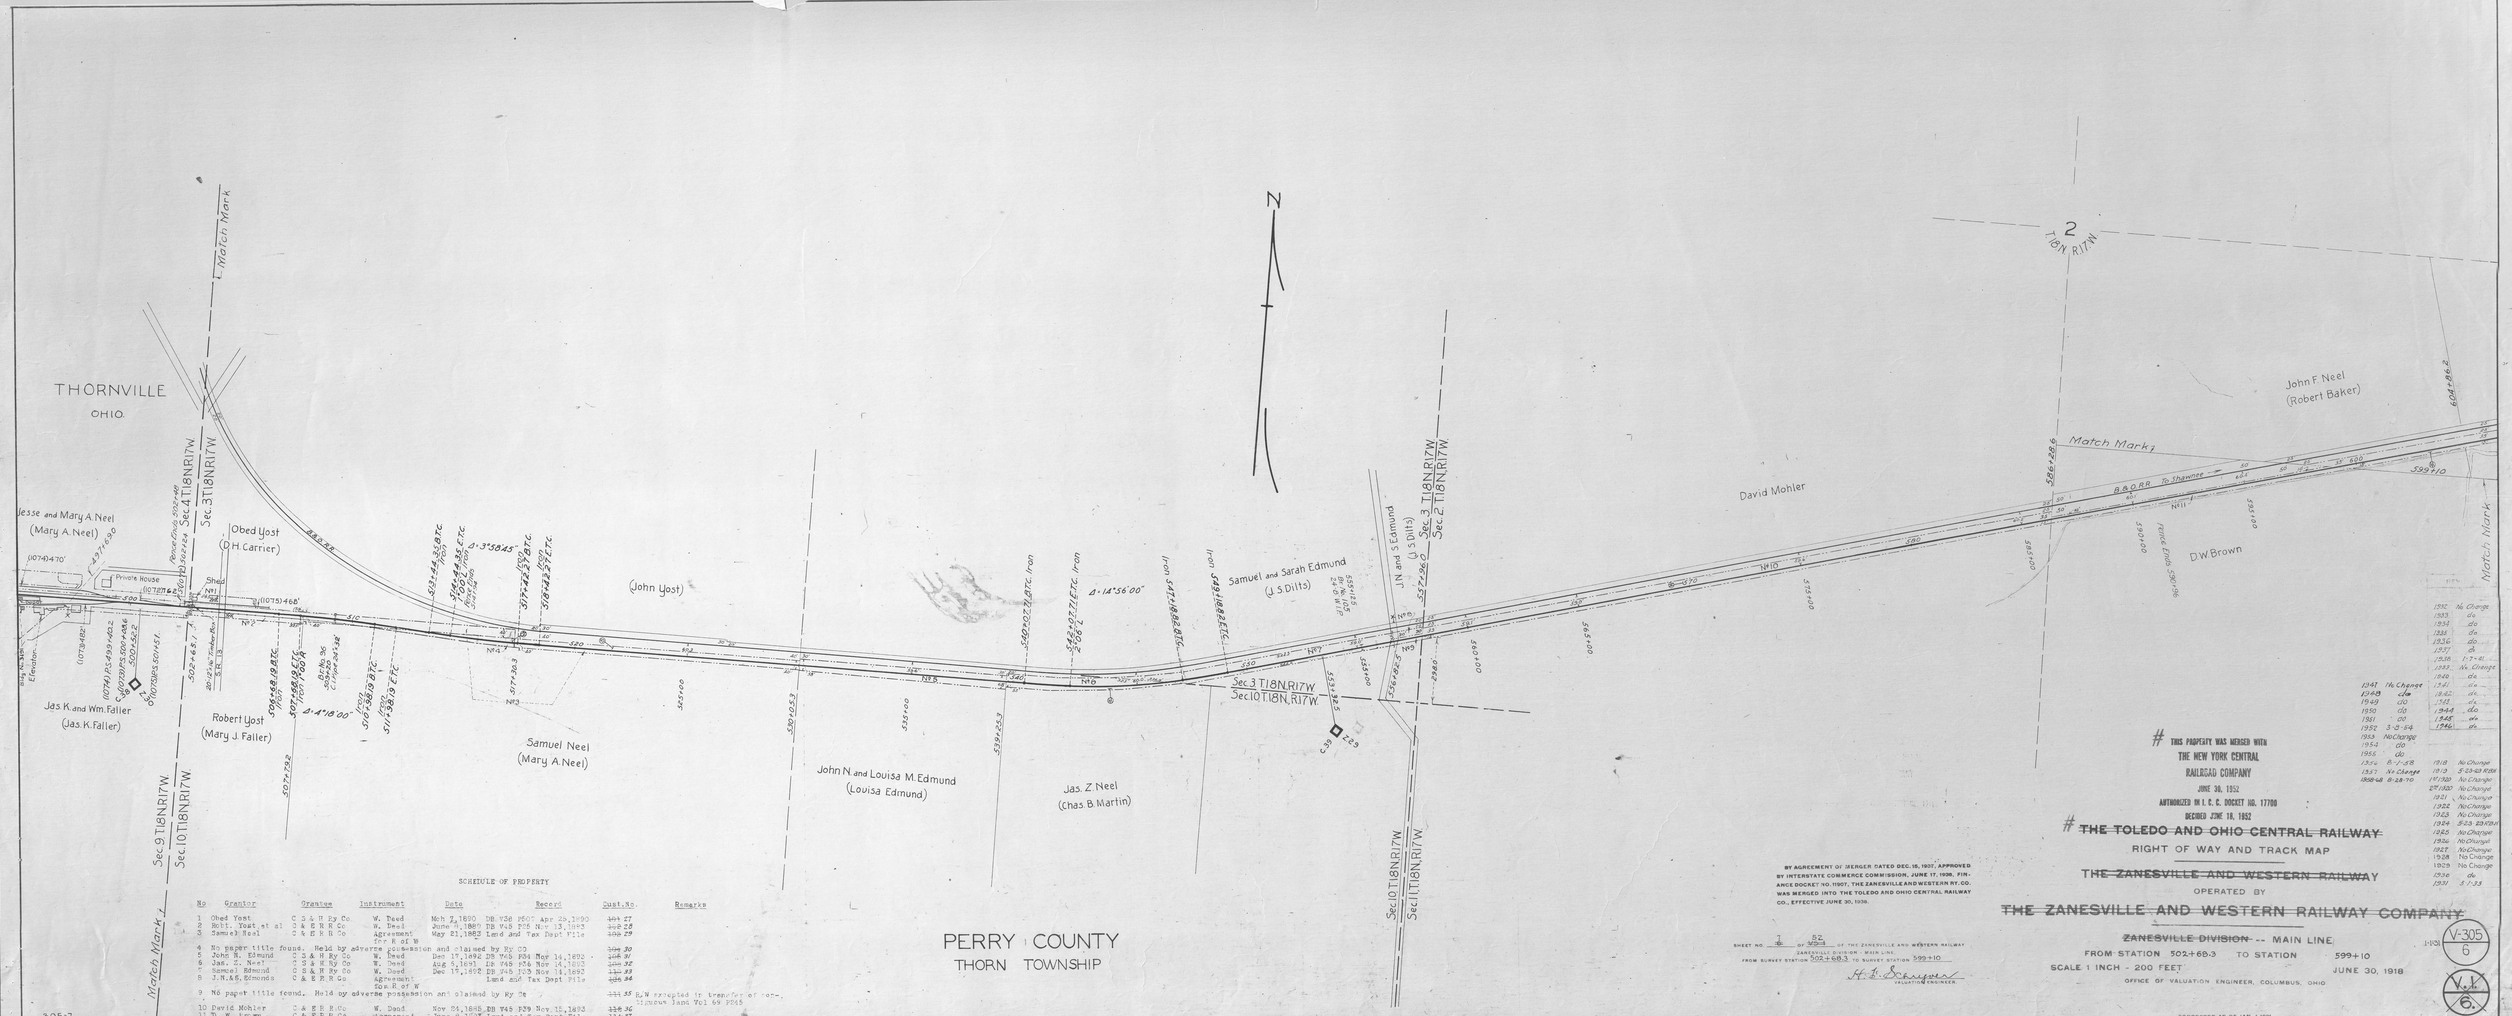


SCHEDULE OF PROPERTY

No	Grantor	Grantee	Instrument	Date	Record	Dist. No.	Remarks
1	Obed Yost	C.S. & H. Ry Co.	W. Deed	Mch 7, 1890	DB. V36 P501 Apr 29, 1890	~~101~~ 27	
2	Robt. Yost et al	C. & E. R.R. Co.	W. Deed	June 9, 1887	DB V45 P26 Nov 13, 1893	~~102~~ 28	
3	Samuel Neal	C. & E. R.R. Co.	Agreement for R of W	May 21, 1883	Land and Tax Dept File	~~103~~ 29	
4	No paper title found. Held by adverse possession and claimed by Ry Co					~~104~~ 30	
5	John N. Edmund	C.S. & H. Ry Co.	W. Deed	Dec 17, 1892	DB V45 P84 Nov 14, 1893	~~105~~ 31	
6	Jas. Z. Neel	C.S. & H. Ry Co.	W. Deed	Aug 5, 1893	DB V45 P54 Nov 14, 1893	~~106~~ 32	
7	Samuel Edmund	C.S. & H. Ry Co.	W. Deed	Dec 17, 1892	DB V45 P103 Nov 14, 1892	~~111~~ 33	
8	J.N. & S. Edmunds	C. & E. R.R. Co.	Agreement for R of W		Land and Tax Dept File	~~105~~ 34	
9	No paper title found. Held by adverse possession and claimed by Ry Co					~~111~~ 35	R.W. excepted in transfer of rem. Unknown Jan. 7th 69 P265
10	David Mohler	C. & E. R.R. Co.	W. Deed	Nov 26, 1895	DB V48 P39 Nov 15, 1893	~~116~~ 36	
11	D. W. Brown	C. & E. R.R. Co.	Agreement for R of W	June 8, 1892	Land and Tax Dept File	~~114~~ 37	

BY AGREEMENT OF JEERGER DATED DEC. 15, 1937, APPROVED BY INTERSTATE COMMERCE COMMISSION, JUNE 17, 1938, FINANCE DOCKET NO. 11907, THE ZANESVILLE AND WESTERN RY. CO. WAS MERGED INTO THE TOLEDO AND OHIO CENTRAL RAILWAY CO., EFFECTIVE JUNE 30, 1938.

SHEET NO. 7 OF 52 SHEETS OF THE ZANESVILLE AND WESTERN RAILWAY ZANESVILLE DIVISION - MAIN LINE
FROM SURVEY STATION 502+68.3 TO SURVEY STATION 599+10

H. T. Sprague
VALUATION ENGINEER

THIS PROPERTY WAS MERGED WITH THE NEW YORK CENTRAL RAILROAD COMPANY JUNE 30, 1952
AUTHORIZED BY I. C. C. DOCKET NO. 17700
DECIDED JUNE 18, 1952

~~THE TOLEDO AND OHIO CENTRAL RAILWAY~~

RIGHT OF WAY AND TRACK MAP

~~THE ZANESVILLE AND WESTERN RAILWAY~~

OPERATED BY

~~THE ZANESVILLE AND WESTERN RAILWAY COMPANY~~

~~ZANESVILLE DIVISION~~ -- MAIN LINE

FROM STATION 502+68.3 TO STATION 599+10

SCALE 1 INCH - 200 FEET

JUNE 30, 1918

OFFICE OF VALUATION ENGINEER, COLUMBUS, OHIO

CORRECTED AS OF JAN. 1 1931
OFFICE OF VALUATION ENGINEER, CLEVELAND, OHIO


V-305
6
V.V.
6.

505-7
A-17-2-7

500 3050 0