
ROW 10: 18.96 ACRES THIS MAP ~~48.70~~ 48.81 Ac. TOTAL

A

OWNER	VALUATION SECTION	SUB DIV.	SHEET NUMBER	REAL ESTATE REMARK
500	3070	-	121	7

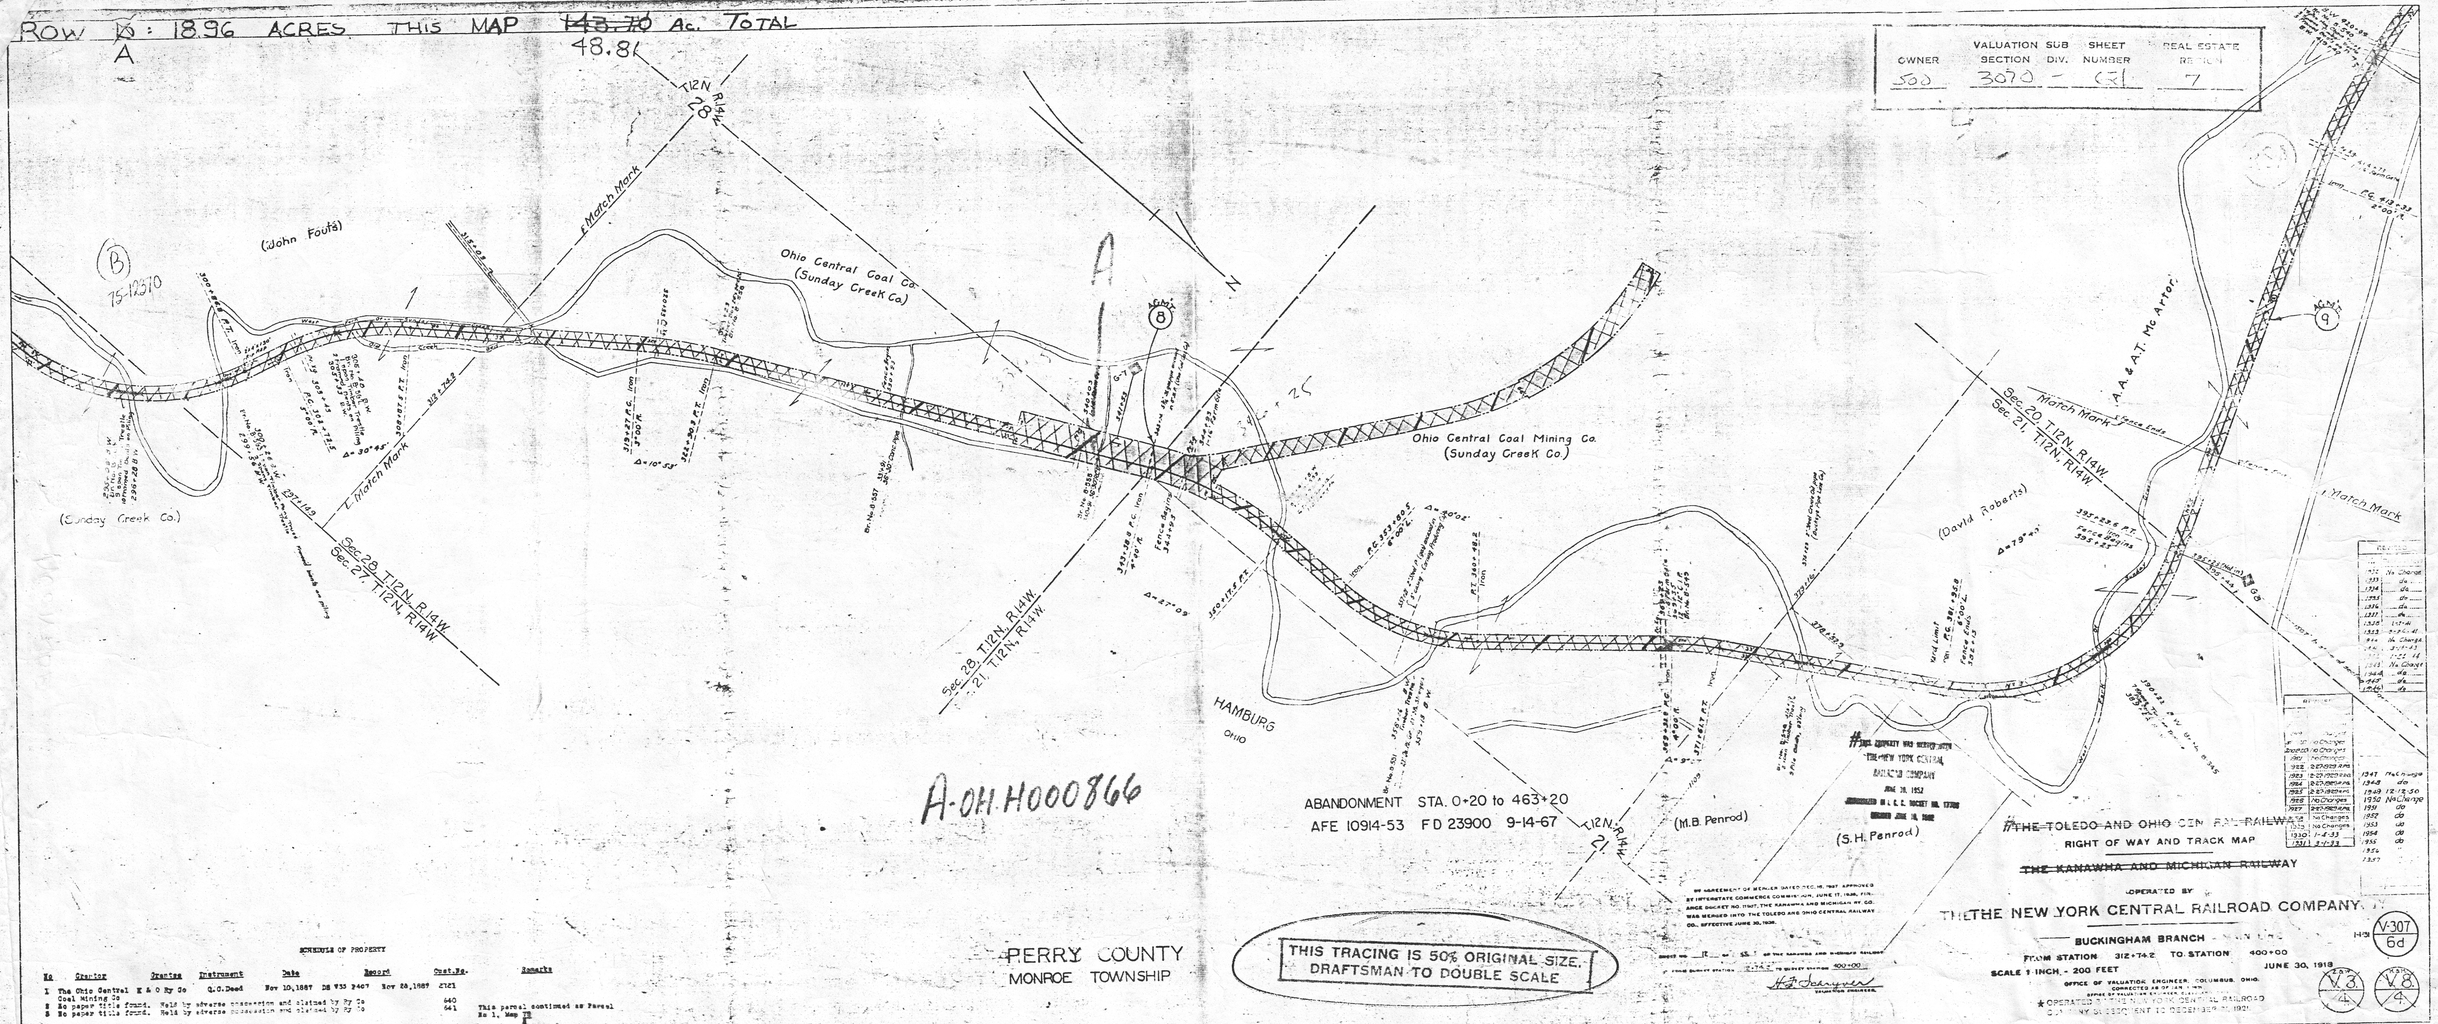

A-OH-H000866

ABANDONMENT STA. 0+20 to 463+20
AFE 10914-53 FD 23900 9-14-67

PERRY COUNTY
MONROE TOWNSHIP

THIS TRACING IS 50% ORIGINAL SIZE.
DRAFTSMAN TO DOUBLE SCALE

SCHEDULE OF PROPERTY

No	Grantor	Grantee	Instrument	Date	Record	Chat. No.	Remarks
1	The Ohio Central K & O Ry Co	Coal Mining Co	Q.C. Deed	Nov 10,1887	DB 933 P467 Nov 28,1887	2121	
2	No paper title found.		Held by adverse possession and platted by Ry Co			640	This parcel continued as Parcel No 1, Map 3
3	No paper title found.		Held by adverse possession and platted by Ry Co			641	

307-12

~~Ac 18-1-24~~

THE TOLEDO AND OHIO CENTRAL RAILWAY
RIGHT OF WAY AND TRACK MAP
~~THE KANAWHA AND MICHIGAN RAILWAY~~

OPERATED BY
THE THE NEW YORK CENTRAL RAILROAD COMPANY.

BUCKINGHAM BRANCH - MAIN LINE

FROM STATION 312+74.2 TO STATION 400+00

SCALE 1 INCH, = 200 FEET JUNE 30, 1918

OFFICE OF VALUATION ENGINEER, COLUMBUS, OHIO.
CONNECTED AS OF JAN. 1, 1929.
OFFICE OF VALUATION ENGINEER, CLEVELAND, OHIO.

★OPERATED BY THE NEW YORK CENTRAL RAILROAD CO. BY SUBSIDIARY TO DECEMBER 31, 1921

H29 V-307 6d

MAPS V 8 4 V 8 4

V6 P15 F3

-N-